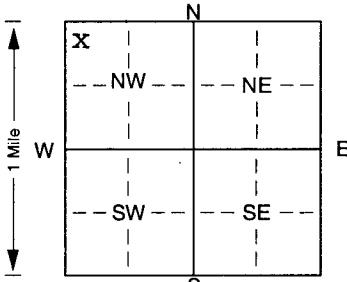


1 LOCATION OF WATER WELL: Fraction NW ¼ NW ¼ NW ¼ Section Number 26 Township Number T 9 S Range Number R 22E E/W
 County: **Leavenworth**

Distance and direction from nearest town or city street address of well if located within city?
1 mile west of Lansing

2 WATER WELL OWNER: **Grant Mckibben**
 RR#, St. Address, Box # : **121 J. St.** Board of Agriculture, Division of Water Resources
 City, State, ZIP Code : **Lansing, Ks. 66043** Application Number:

3 LOCATE WELL'S LOCATION WITH AN "X" IN SECTION BOX:

 4 DEPTH OF COMPLETED WELL: **240** ft. ELEVATION:
 Depth(s) Groundwater Encountered 1. ft. 2. ft. 3. ft.
 WELL'S STATIC WATER LEVEL **70** ft. below land surface measured on mo/day/yr **9-28-2001**
 Pump test data: Well water was ft. after hours pumping gpm
 Est. Yield $\frac{1}{2}$ gpm: Well water was ft. after hours pumping gpm
 Bore Hole Diameter. **8. 3/4** in. to ft., and in. to ft.
 WELL WATER TO BE USED AS: 5 Public water supply 8 Air conditioning 11 Injection well
 1 Domestic 3 Feedlot 6 Oil field water supply 9 Dewatering 12 Other (Specify below)
 2 Irrigation 4 Industrial 7 Domestic (lawn & garden) 10 Monitoring well
 Was a chemical/bacteriological sample submitted to Department? Yes. No. **X**; If yes, mo/day/yr sample was submitted
 Water Well Disinfected? Yes **X** No

5 TYPE OF BLANK CASING USED:
 1 Steel 3 RMP (SR) 5 Wrought iron 8 Concrete tile CASING JOINTS: Glued. **X** Clamped.
 2 PVC 4 ABS 6 Asbestos-Cement 9 Other (specify below) Welded.
 7 Fiberglass Threaded.
 Blank casing diameter **5** in. to ft., Dia. in. to ft., Dia. in. to ft.
 Casing height above land surface. **24** in., weight **2.82** lbs./ft. Wall thickness or gauge No. **258**
 TYPE OF SCREEN OR PERFORATION MATERIAL:
 1 Steel 3 Stainless steel 5 Fiberglass **7 PVC** 10 Asbestos-cement
 2 Brass 4 Galvanized steel 6 Concrete tile 8 RMP (SR) 11 Other (specify)
 9 ABS 12 None used (open hole)
 SCREEN OR PERFORATION OPENINGS ARE:
 1 Continuous slot 3 Mill slot 5 Gauzed wrapped 8 Saw cut 11 None (open hole)
 2 Louvered shutter 4 Key punched 6 Wire wrapped 9 Drilled holes
 7 Torch cut 10 Other (specify) ft.
 SCREEN-PERFORATED INTERVALS: From **70** ft. to **100** ft., From ft. to ft.
 From **238** ft. to **240** ft., From ft. to ft.
 GRAVEL PACK INTERVALS: From **24** ft. to **240** ft., From ft. to ft.
 From ft. to ft., From ft. to ft.

6 GROUT MATERIAL: 1 Neat cement 2 Cement grout **3 Bentonite** 4 Other
 Grout intervals: From **4** ft. to **24** ft., From ft. to ft., From ft. to ft.
 What is the nearest source of possible contamination:
 1 Septic tank 4 Lateral lines 7 Pit privy 10 Livestock pens 14 Abandoned water well
 2 Sewer lines 5 Cess pool 8 Sewage lagoon 11 Fuel storage 15 Oil well/Gas well
 3 Watertight sewer lines 6 Seepage pit 9 Feedyard 12 Fertilizer storage 16 Other (specify below)
 13 Insecticide storage
 Direction from well? **South** How many feet? **110**

FROM	TO	LITHOLOGIC LOG	FROM	TO	PLUGGING INTERVALS
0	7	brown clay	147	164	grey shale
7	8	red boulders	164	165	grey limestone
8	14	brown clay	165	172	tan shale
14	16	yellow shale	172	185	grey limestone
16	19	grey limestone	185	189	grey shale
19	49	yellow sandy shale	189	193	grey limestone
49	60	brown sandstone	193	215	grey shale
60	70	yellow sandy shale	215	224	grey limestone
70	83	yellow sandstone	224	225	grey shale
83	86	grey shale	225	229	grey limestone
86	88	grey sandstone	229	238	grey shale
88	106	grey shale	238	240	grey limestone
106	146	grey sandy shale			
146	147	grey limestone			

7 CONTRACTOR'S OR LANDOWNER'S CERTIFICATION: This water well was (1) constructed, (2) reconstructed, or (3) plugged under my jurisdiction and was completed on (mo/day/year) **9-28-2001** and this record is true to the best of my knowledge and belief. Kansas Water Well Contractor's Licence No. **182**. This Water Well Record was completed on (mo/day/yr) **10-02-2001** under the business name of **Strader Drilling Co., Inc.** by (signature) *Dale Strader*