


1) LOCATION OF WATER WELL: County: <u>Leavenworth</u>	Fraction SW $\frac{1}{4}$ SW $\frac{1}{4}$ NE $\frac{1}{4}$	Section Number <u>1</u>	Township Number T <u>9</u> S	Range Number R <u>22</u> <b>(E)</b>
--	--	----------------------------	---------------------------------	--

Distance and direction from nearest town or city street address of well if located within city?  
4th & Marion - Leavenworth, Kansas

2) WATER WELL OWNER: Four B Corporation  
 RR#, St. Address, Box # : 5300 Speaker Road  
 City, State, ZIP Code : Kansas City, Kansas  
 Board of Agriculture, Division of Water Resources  
 Application Number: \_\_\_\_\_

3) LOCATE WELL'S LOCATION WITH AN "X" IN SECTION BOX:      4) DEPTH OF COMPLETED WELL 24 ft. ELEVATION: \_\_\_\_\_

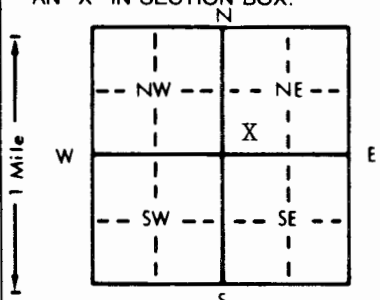

Depth(s) Groundwater Encountered 1. \_\_\_\_\_ ft. 2. \_\_\_\_\_ ft. 3. \_\_\_\_\_ ft.  
 WELL'S STATIC WATER LEVEL 11.2 ft. below land surface measured on mo/day/yr 11-24-89  
 Pump test data: Well water was \_\_\_\_\_ ft. after \_\_\_\_\_ hours pumping \_\_\_\_\_ gpm  
 Est. Yield \_\_\_\_\_ gpm: Well water was \_\_\_\_\_ ft. after \_\_\_\_\_ hours pumping \_\_\_\_\_ gpm  
 Bore Hole Diameter 7 in. to 24 ft., and \_\_\_\_\_ in. to \_\_\_\_\_ ft.  
 WELL WATER TO BE USED AS: 5 Public water supply 8 Air conditioning 11 Injection well  
 1 Domestic 3 Feedlot 6 Oil field water supply 9 Dewatering 12 Other (Specify below)  
 2 Irrigation 4 Industrial 7 Lawn and garden only 10 Monitoring well  
 Was a chemical/bacteriological sample submitted to Department? Yes \_\_\_\_\_ No X; If yes, mo/day/yr sample was submitted \_\_\_\_\_  
 Water Well Disinfected? Yes \_\_\_\_\_ No X

5) TYPE OF BLANK CASING USED:      5 Wrought iron      8 Concrete tile      CASING JOINTS: Glued \_\_\_\_\_ Clamped \_\_\_\_\_  
 1 Steel      3 RMP (SR)      6 Asbestos-Cement      9 Other (specify below)      Welded \_\_\_\_\_  
 2 PVC      4 ABS      7 Fiberglass      \_\_\_\_\_      Threaded X  
 Blank casing diameter 2 in. to \_\_\_\_\_ ft., Dia \_\_\_\_\_ in. to \_\_\_\_\_ ft., Dia \_\_\_\_\_ in. to \_\_\_\_\_ ft.  
 Casing height above land surface \_\_\_\_\_ in., weight \_\_\_\_\_ lbs./ft. Wall thickness or gauge No. \_\_\_\_\_

TYPE OF SCREEN OR PERFORATION MATERIAL:      7 PVC      10 Asbestos-cement  
 1 Steel      3 Stainless steel      5 Fiberglass      8 RMP (SR)      11 Other (specify) \_\_\_\_\_  
 2 Brass      4 Galvanized steel      6 Concrete tile      9 ABS      12 None used (open hole)

SCREEN OR PERFORATION OPENINGS ARE:      5 Gauzed wrapped      8 Saw cut      11 None (open hole)  
 1 Continuous slot      3 Mill slot      6 Wire wrapped      9 Drilled holes  
 2 Louvered shutter      4 Key punched      7 Torch cut      10 Other (specify) \_\_\_\_\_

SCREEN-PERFORATED INTERVALS: From \_\_\_\_\_ ft. to \_\_\_\_\_ ft., From \_\_\_\_\_ ft. to \_\_\_\_\_ ft.  
 From \_\_\_\_\_ ft. to \_\_\_\_\_ ft., From \_\_\_\_\_ ft. to \_\_\_\_\_ ft.  
 GRAVEL PACK INTERVALS: From \_\_\_\_\_ ft. to \_\_\_\_\_ ft., From \_\_\_\_\_ ft. to \_\_\_\_\_ ft.  
 From \_\_\_\_\_ ft. to \_\_\_\_\_ ft., From \_\_\_\_\_ ft. to \_\_\_\_\_ ft.

6) GROUT MATERIAL:      1 Neat cement      2 Cement grout      3 Bentonite      4 Other \_\_\_\_\_  
 Grout Intervals: From 3 ft. to 24 ft., From \_\_\_\_\_ ft. to \_\_\_\_\_ ft., From \_\_\_\_\_ ft. to \_\_\_\_\_ ft.

What is the nearest source of possible contamination:  
 1 Septic tank      4 Lateral lines      7 Pit privy      10 Livestock pens      14 Abandoned water well  
 2 Sewer lines      5 Cess pool      8 Sewage lagoon      11 Fuel storage      15 Oil well/Gas well  
 3 Watertight sewer lines      6 Seepage pit      9 Feedyard      12 Fertilizer storage      16 Other (specify below)  
 13 Insecticide storage  
 Direction from well? NORTH      How many feet? 50'

FROM	TO	LITHOLOGIC LOG	FROM	TO	PLUGGING INTERVALS
			3	24	Casing Removed & Grout Tremmied from Bottom to Top

7) CONTRACTOR'S OR LANDOWNER'S CERTIFICATION: This water well was (1) constructed, (2) reconstructed, or (3) plugged under my jurisdiction and was completed on (mo/day/year) 6/27/90 and this record is true to the best of my knowledge and belief. Kansas Water Well Contractor's License No. 416 This Water Well Record was completed on (mo/day/yr) 7/13/90 under the business name of Terracon by (signature) W.G. Semley

INSTRUCTIONS: Use typewriter or ball point pen. PLEASE PRESS FIRMLY and PRINT clearly. Please fill in blanks, underline or circle the correct answers. Send top three copies to Kansas Department of Health and Environment, Bureau of Water, Topeka, Kansas 66620-7320. Telephone: 913-296-5545. Send one to WATER WELL OWNER and retain one for your records.