


1 LOCATION OF WATER WELL: County: <u>Leavenworth</u>	Fraction <u>NW 1/4 SW 1/4 NE 1/4</u>	Section Number <u>1</u>	Township Number T <u>9</u> S	Range Number R <u>22</u> <u>EW</u>
---	---	----------------------------	---------------------------------	---------------------------------------

Distance and direction from nearest town or city street address of well if located within city?
1825 S. 4th Street Leavenworth, Ks.

2 WATER WELL OWNER: <u>GNB</u> RR#, St. Address, Box #: <u>1825 S. 4th St.</u> City, State, ZIP Code: <u>Leavenworth, Ks.</u>	Board of Agriculture, Division of Water Resources Application Number:
---	--

3 LOCATE WELL'S LOCATION WITH AN "X" IN SECTION BOX:

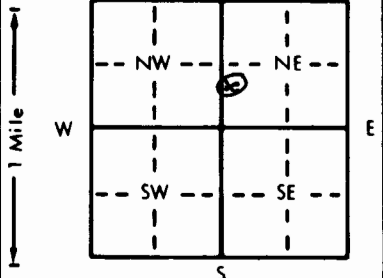

4 DEPTH OF COMPLETED WELL: <u>25</u> ft.	ELEVATION: <u>782.5</u>
--	-------------------------

Depth(s) Groundwater Encountered 1. ft. 2. ft. 3. ft.

WELL'S STATIC WATER LEVEL: 6 ft. below land surface measured on mo/day/yr 4/15/92

Not Tested. Pump test data: Well water was ft. after hours pumping gpm

Est. Yield gpm: Well water was ft. after hours pumping gpm

Bore Hole Diameter: 7 in. to 2.5 ft., and in. to ft.

WELL WATER TO BE USED AS:

5 Public water supply	8 Air conditioning	11 Injection well
1 Domestic	3 Feedlot	6 Oil field water supply
2 Irrigation	4 Industrial	7 Lawn and garden only
		<u>10 Monitoring well</u>
		12 Other (Specify below)

Was a chemical/bacteriological sample submitted to Department? Yes No X; If yes, mo/day/yr sample was submitted

Water Well Disinfected? Yes No X

5 TYPE OF BLANK CASING USED:	5 Wrought iron	8 Concrete tile	CASING JOINTS: Glued Clamped
1 Steel	3 RMP (SR)	6 Asbestos-Cement	9 Other (specify below)
<u>2 PVC</u>	4 ABS	7 Fiberglass	Welded
			<u>Threaded</u>

Blank casing diameter: 2 in. to 1.5 ft., Dia. in. to ft., Dia. in. to ft.

Casing height above land surface: 5.5 in., weight lbs./ft. Wall thickness or gauge No. Sch. 40

TYPE OF SCREEN OR PERFORATION MATERIAL:	<u>7 PVC</u>	10 Asbestos-cement
1 Steel	3 Stainless steel	5 Fiberglass
2 Brass	4 Galvanized steel	6 Concrete tile
		8 RMP (SR)
		9 ABS
		11 Other (specify)
		12 None used (open hole)

SCREEN OR PERFORATION OPENINGS ARE:	5 Gauzed wrapped	8 Saw cut	11 None (open hole)
1 Continuous slot	<u>3 Mill slot</u>	6 Wire wrapped	9 Drilled holes
2 Louvered shutter	4 Key punched	7 Torch cut	10 Other (specify)

SCREEN-PERFORATED INTERVALS: From 2.5 ft. to 15 ft., From ft. to ft.

GRAVEL PACK INTERVALS: From 2.5 ft. to 13 ft., From ft. to ft.

6 GROUT MATERIAL:	1 Neat cement	<u>2 Cement grout</u>	<u>3 Bentonite</u>	4 Other
-------------------	---------------	-----------------------	--------------------	-------------------

Grout Intervals: From 1.3 ft. to 10.5 ft., From 10.5 ft. to 0 ft., From ft. to ft.

What is the nearest source of possible contamination:

1 Septic tank	4 Lateral lines	7 Pit privy	10 Livestock pens	14 Abandoned water well
2 Sewer lines	5 Cess pool	8 Sewage lagoon	11 Fuel storage	15 Oil well/Gas well
3 Watertight sewer lines	6 Seepage pit	9 Feedyard	12 Fertilizer storage	<u>16 Other</u> (specify below)
			13 Insecticide storage	<u>Mfg. Plant</u>

Direction from well? How many feet?

FROM	TO	LITHOLOGIC LOG	FROM	TO	PLUGGING INTERVALS
0	4	Fill, sand, cinders			
4	12.5	Clayey silt, yellow-brown			
12.5	25	silt-silty sands w/ small clay layers, olive grey			

7 CONTRACTOR'S OR LANDOWNER'S CERTIFICATION: This water well was <u>(1) constructed</u> , <u>(2) reconstructed</u> , or <u>(3) plugged</u> under my jurisdiction and was completed on (mo/day/year) <u>4/22/92</u> and this record is true to the best of my knowledge and belief. Kansas Water Well Contractor's License No. <u>519</u> This Water Well Record was completed on (mo/day/yr) <u>4/6/1992</u> under the business name of <u>West Hazmat Drilling Corp</u> by (signature) <u>Jay P. Jones</u>

INSTRUCTIONS: Use typewriter or ball point pen. PLEASE PRESS FIRMLY and PRINT clearly. Please fill in blanks, underline or circle the correct answers, send top three copies to Kansas Department of Health and Environment, Bureau of Water, Topeka, Kansas 66620-0001. Telephone: 913-296-5545. Send one to WATER WELL OWNER and retain one for your records.