


1 LOCATION OF WATER WELL: County: Leavenworth Fraction: NW 1/4 SW 1/4 NE 1/4 Section Number: 1 Township Number: T 9 S Range Number: R 22 E

Distance and direction from nearest town or city street address of well if located within city?
1825 S. 4th St. Leavenworth, KS.

2 WATER WELL OWNER: GNB
 RR#, St. Address, Box #: 1825 South 4th St. Board of Agriculture, Division of Water Resources
 City, State, ZIP Code: Leavenworth, KS Application Number:

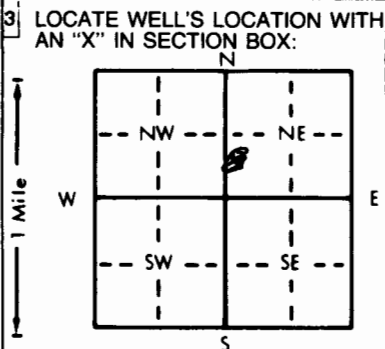

4 DEPTH OF COMPLETED WELL: 49 ft. ELEVATION: 794

Depth(s) Groundwater Encountered 1. ft. 2. ft. 3. ft.

WELL'S STATIC WATER LEVEL: 18 ft. below land surface measured on mo/day/yr 4/15/92

Tested Pump test data: Well water was ft. after hours pumping gpm

Est. Yield gpm: Well water was ft. after hours pumping gpm

Bore Hole Diameter: 7 in. to 49 ft., and in. to ft.

WELL WATER TO BE USED AS:

5 Public water supply	8 Air conditioning	11 Injection well
1 Domestic	3 Feedlot	6 Oil field water supply
2 Irrigation	4 Industrial	7 Lawn and garden only
		<u>10 Monitoring well</u>

Was a chemical/bacteriological sample submitted to Department? Yes. No. X If yes, mo/day/yr sample was submitted

Water Well Disinfected? Yes No X

5 TYPE OF BLANK CASING USED:

1 Steel	3 RMP (SR)	6 Asbestos-Cement	9 Other (specify below)	Welded
<u>2 PVC</u>	4 ABS	7 Fiberglass		<u>Threaded</u>

Blank casing diameter: 2 in. to 39 ft., Dia. in. to ft., Dia. in. to ft.

Casing height above land surface: (-) 5 in., weight lbs./ft. Wall thickness or gauge No. sch. 40

TYPE OF SCREEN OR PERFORATION MATERIAL:

1 Steel	3 Stainless steel	5 Fiberglass	8 RMP (SR)	10 Asbestos-cement
2 Brass	4 Galvanized steel	6 Concrete tile	9 ABS	11 Other (specify)
				12 None used (open hole)

SCREEN OR PERFORATION OPENINGS ARE:

1 Continuous slot	<u>3 Mill slot</u>	5 Gauzed wrapped	8 Saw cut	11 None (open hole)
2 Louvered shutter	4 Key punched	6 Wire wrapped	9 Drilled holes	
		7 Torch cut	10 Other (specify)	

SCREEN-PERFORATED INTERVALS: From 49 ft. to 39 ft., From ft. to ft.

GRAVEL PACK INTERVALS: From 49 ft. to 36.5 ft., From ft. to ft.

6 GROUT MATERIAL: 1 Neat cement 2 Cement grout 3 Bentonite 4 Other

Grout Intervals: From 36.5 ft. to 33.5 ft., From 33.5 ft. to 0 ft., From ft. to ft.

What is the nearest source of possible contamination:

1 Septic tank	4 Lateral lines	7 Pit privy	10 Livestock pens	14 Abandoned water well
2 Sewer lines	5 Cess pool	8 Sewage lagoon	11 Fuel storage	15 Oil well/Gas well
3 Watertight sewer lines	6 Seepage pit	9 Feedyard	12 Fertilizer storage	<u>16 Other (specify below)</u>
			13 Insecticide storage	<u>Mfg. Plant</u>

Direction from well? How many feet?

FROM	TO	LITHOLOGIC LOG	FROM	TO	PLUGGING INTERVALS
0	1.5	Silt w/clay - Back Fill			
1.5	46	Clayey Silt - DK Yellow Ben, Mottled w/Fron stains			
46	48	Sandy Silt - Grey			
48	49	Weathered Limestone Orange - Yellow			

7 CONTRACTOR'S OR LANDOWNER'S CERTIFICATION: This water well was (1) constructed, (2) reconstructed, or (3) plugged under my jurisdiction and was completed on (mo/day/year) 4/6/92 and this record is true to the best of my knowledge and belief. Kansas Water Well Contractor's License No. 519 This Water Well Record was completed on (mo/day/yr) 4/6/92 under the business name of West Hazmet Drilling Corp. by (signature) [Signature]

INSTRUCTIONS: Use typewriter or ball point pen. PLEASE PRESS FIRMLY and PRINT clearly. Please fill in blanks, underline or circle the correct answers. Send top three copies to Kansas Department of Health and Environment, Bureau of Water, Topeka, Kansas 66620-0001. Telephone: 913-296-5545. Send one to WATER WELL OWNER and retain one for your records.