


1 LOCATION OF WATER WELL: Fraction SE 1/4 SE 1/4 NW 1/4 Section Number 4 Township Number T 9 S Range Number R 22 E
 County: LEAVENWORTH

Distance and direction from nearest town or city street address of well if located within city?
1/2 west Leavenworth

2 WATER WELL OWNER: ~~Jim Snowberg~~ c/o Donald Toevs
 RR#, St. Address, Box #: Jim Snowberg 2617 North 69th Board of Agriculture, Division of Water Resources
 City, State, ZIP Code: Kansas City, KS 66109 Application Number:

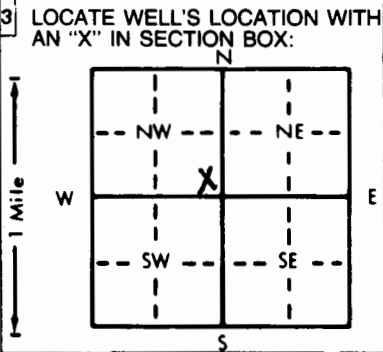

4 DEPTH OF COMPLETED WELL: 260 ft. ELEVATION:
 Depth(s) Groundwater Encountered 1. 204 ft. 2. ft. 3. ft.
 WELL'S STATIC WATER LEVEL 170' ft. below land surface measured on mo/day/yr 10-21-87
 Pump test data: Well water was ft. after hours pumping gpm
 Est. Yield .7 gpm: Well water was ft. after hours pumping gpm
 Bore Hole Diameter 8" in. to ft., and in. to ft.
 WELL WATER TO BE USED AS:
1 Domestic 3 Feedlot 6 Oil field water supply 9 Dewatering 12 Other (Specify below)
2 Irrigation 4 Industrial 7 Lawn and garden only 10 Observation well
 Was a chemical/bacteriological sample submitted to Department? Yes No X; If yes, mo/day/yr sample was submitted
 Water Well Disinfected? Yes X No

5 TYPE OF BLANK CASING USED:
 1 Steel 3 RMP (SR) 5 Wrought iron 8 Concrete tile CASING JOINTS: Glued X Clamped
 2 PVC 4 ABS 6 Asbestos-Cement 9 Other (specify below) Welded
 7 Fiberglass Threaded
 Blank casing diameter 5" in. to 0-200 ft., Dia 5" in. to 220-260 ft., Dia in. to ft.
 Casing height above land surface 24" in., weight 2.82 lbs./ft. Wall thickness or gauge No. .258
 TYPE OF SCREEN OR PERFORATION MATERIAL:
 1 Steel 3 Stainless steel 5 Fiberglass 7 PVC 10 Asbestos-cement
 2 Brass 4 Galvanized steel 6 Concrete tile 8 RMP (SR) 11 Other (specify)
 12 None used (open hole)
 SCREEN OR PERFORATION OPENINGS ARE:
 1 Continuous slot 3 Mill slot 5 Gauzed wrapped 8 Saw cut 11 None (open hole)
 2 Louvered shutter 4 Key punched 6 Wire wrapped 9 Drilled holes
 7 Torch cut 10 Other (specify)
 SCREEN-PERFORATED INTERVALS: From 200 ft. to 220 ft., From ft. to ft.
 From ft. to ft., From ft. to ft.
 GRAVEL PACK INTERVALS: From 20 ft. to 260 ft., From ft. to ft.
 From ft. to ft., From ft. to ft.

6 GROUT MATERIAL: 1 Neat cement 2 Cement grout 3 Bentonite 4 Other
 Grout Intervals: From 0 ft. to 20 ft., From ft. to ft., From ft. to ft.
 What is the nearest source of possible contamination:
 1 Septic tank 4 Lateral lines 7 Pit privy 11 Fuel storage 14 Abandoned water well
 2 Sewer lines 5 Cess pool 8 Sewage lagoon 12 Fertilizer storage 15 Oil well/Gas well
 3 Watertight sewer lines 6 Seepage pit 9 Feedyard 13 Insecticide storage 16 Other (specify below)
 Direction from well? NW How many feet? 200

FROM	TO	LITHOLOGIC LOG	FROM	TO	LITHOLOGIC LOG
0	9	Clay-Brown			
9	21	Shale-Yellow			
21	129	Shale-Grey			
129	135	Limestone-Grey			
135	153	Sandstone-Grey			
153	204	Sandy Shale-Grey			
204	216	Sandstone-Grey (7 GPM)			
216	260	Shale-Grey			
		11-19-87 Well is only 17' from property line. Talked with Daryl Plummer with KDHE. He said this was alright and gave his approval.			

7 CONTRACTOR'S OR LANDOWNER'S CERTIFICATION: This water well was (1) constructed, (2) reconstructed, or (3) plugged under my jurisdiction and was completed on (mo/day/year) 10-21-87 and this record is true to the best of my knowledge and belief. Kansas Water Well Contractor's License No. 182 This Water Well Record was completed on (mo/day/yr) 12-10-87 under the business name of Strader Drilling Co., Inc. by (signature) Dale Strader