


WATER WELL RECORD Form WWC-5 KSA 82a-1212

1 LOCATION OF WATER WELL: County: Leavenworth Fraction: SW 1/4 SE 1/4 NW 1/4 Section Number: 7 Township Number: T 9 S Range Number: R 22 E

Distance and direction from nearest town or city street address of well if located within city?
Bldg. #54 Old Fuel Storage Tank Farm Location; Within Leavenworth, Ks.

2 WATER WELL OWNER: V. A. Hospital Firehouse #54
 RR#, St. Address, Box #: U.S. Court Board of Agriculture, Division of Water Resources
 City, State, ZIP Code: Leavenworth, Ks. Application Number:

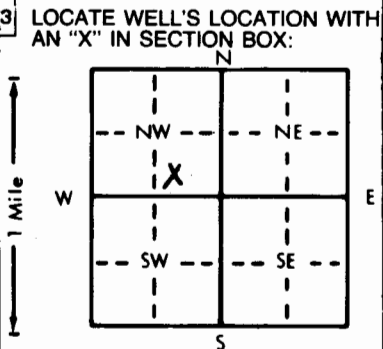

4 DEPTH OF COMPLETED WELL: 40ft ft. ELEVATION:
 Depth(s) Groundwater Encountered 1. none ft. 2. ft. 3. ft.
 WELL'S STATIC WATER LEVEL: ft. below land surface measured on mo/day/yr 2/28/92
 Pump test data: Well water was ft. after hours pumping gpm
 Est. Yield gpm: Well water was ft. after hours pumping gpm
 Bore Hole Diameter: 6 5/8 in. to 40 ft., and in. to ft.
 WELL WATER TO BE USED AS:
 1 Domestic 3 Feedlot 6 Oil field water supply 8 Air conditioning 11 Injection well
 2 Irrigation 4 Industrial 7 Lawn and garden only 10 Monitoring well 12 Other (Specify below)
 Was a chemical/bacteriological sample submitted to Department? Yes No X; If yes, mo/day/yr sample was submitted Water Well Disinfected? Yes No

5 TYPE OF BLANK CASING USED:
 1 Steel 3 RMP (SR) 5 Wrought iron 8 Concrete tile CASING JOINTS: Glued Clamped
2 PVC 4 ABS 6 Asbestos-Cement 9 Other (specify below) Welded
 7 Fiberglass Threaded X
 Blank casing diameter 2.41 in. to 20 ft., Dia. in. to ft., Dia. in. to ft.
 Casing height above land surface Flush Mount in., weight lbs./ft. Wall thickness or gauge No. SDR-13
 TYPE OF SCREEN OR PERFORATION MATERIAL: 7 PVC 10 Asbestos-cement Sen 40
 1 Steel 3 Stainless steel 5 Fiberglass 8 RMP (SR) 11 Other (specify)
 2 Brass 4 Galvanized steel 6 Concrete tile 9 ABS 12 None used (open hole)
 SCREEN OR PERFORATION OPENINGS ARE:
 1 Continuous slot 3 Mill slot .010 5 Gauzed wrapped 8 Saw cut 11 None (open hole)
 2 Louvered shutter 4 Key punched 7 Torch cut 9 Drilled holes
 SCREEN-PERFORATED INTERVALS: From 40 ft. to 20 ft., From ft. to ft.
 GRAVEL PACK INTERVALS: From 40 ft. to 19 ft., From ft. to ft.

6 GROUT MATERIAL: 1 Neat cement 2 Cement grout 3 Bentonite 4 Other
 Grout Intervals: From 19 ft. to 2 ft., From 2 ft. to 0 ft., From ft. to ft.
 What is the nearest source of possible contamination:
 1 Septic tank 4 Lateral lines 7 Pit privy 10 Livestock pens 14 Abandoned water well
 2 Sewer lines 5 Cess pool 8 Sewage lagoon 11 Fuel storage 15 Oil well/Gas well
 3 Watertight sewer lines 6 Seepage pit 9 Feedyard 12 Fertilizer storage 16 Other (specify below)
 Direction from well? South How many feet? 10ft Old Fuel Storage Site

FROM	TO	LITHOLOGIC LOG	FROM	TO	PLUGGING INTERVALS
0	1/2	Brown soil fill			
1/2	3	DK Brown to Black silty clay, w/ls. rx. frag.			
3	11 1/4	Brown silty sandy clay, small rx. gravel very fine sand			
11 1/4	13 1/2	Reddish Br. silty clay			
13 1/2	17	lt. Brown silty sandy clay, fine sand			
17	19 1/2	Blue-green silty sandy clay, yel. fine sand			
19 1/2	24 1/2	Gray-Blue-green silty sandy clay			
24 1/2	31	lt. Gray- lt. Green silty sandy clay, very fine sand			
31	39	Yellow-tan-brown silty liney clay w/ small ls. rx. frag.			
39	40	White tan weathered chalky limestone			

7 CONTRACTOR'S OR LANDOWNER'S CERTIFICATION: This water well was (1) constructed, (2) reconstructed, or (3) plugged under my jurisdiction and was completed on (mo/day/yr) 2/28/92 and this record is true to the best of my knowledge and belief. Kansas Water Well Contractor's License No. 539 This Water Well Record was completed on (mo/day/yr) 3/1/92 under the business name of Q.B. Environmental Drilling by (signature) James Bicker

INSTRUCTIONS: Use typewriter or ball point pen. PLEASE PRESS FIRMLY and PRINT clearly. Please fill in blanks, underline or circle the correct answers. Send top three copies to Kansas Department of Health and Environment, Bureau of Water, Topeka, Kansas 66620-0001. Telephone: 913-296-5545. Send one to WATER WELL OWNER and retain one for your records.