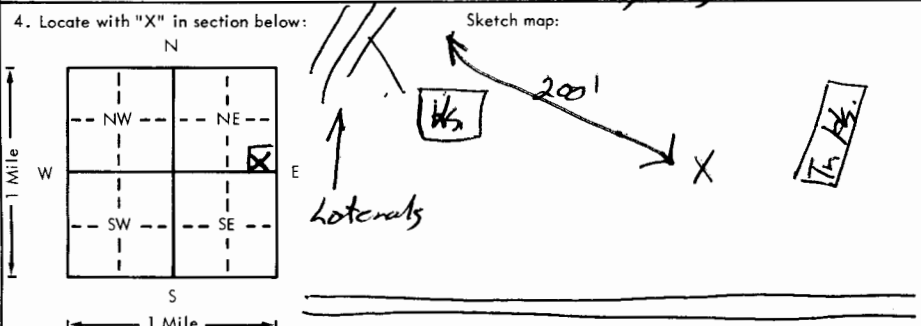


USE TYPEWRITER OR BALL POINT PEN-PRESS FIRMLY, PRINT CLEARLY.

WATER WELL RECORD
KSA 82a-1201-1215

Kansas Department of Health and Environment-Division of Environment (Water well Contractors) Topeka, Kansas 66620

| | | | | | |
|---|------------------------------|--|--|-------------------------------|---|
| 1. Location of well: | County <u>Leavenworth</u> | Fraction <u>SE 1/4 SE 1/4 NE 1/4</u> | Section number <u>9</u> | Township number T <u>9</u> | Range number S R <u>22</u> <u>EW</u> |
| 2. Distance and direction from nearest town or city: Street address of well location if in city: <u>Leavenworth City Limits</u> | | | 3. Owner of well: <u>Al Cowling</u> R.R. or street: <u>2800 S. 14th</u> City, state, zip code: <u>Leavenworth, KS. 66048</u> | | |
| 4. Locate with "X" in section below:  | | | 6. Bore hole dia. <u>5</u> in. Completion date <u>8-14-78</u> Well depth <u>80</u> ft. | | |
| 5. Type and color of material | | | 7. <input type="checkbox"/> Cable tool <input checked="" type="checkbox"/> Rotary <input type="checkbox"/> Driven <input type="checkbox"/> Dug <input type="checkbox"/> Hollow rod <input type="checkbox"/> Jetted <input type="checkbox"/> Bored <input type="checkbox"/> Reverse rotary | | |
| | | | 8. Use: <input checked="" type="checkbox"/> Domestic <input type="checkbox"/> Public supply <input type="checkbox"/> Industry <input type="checkbox"/> Irrigation <input type="checkbox"/> Air conditioning <input type="checkbox"/> Stock <input type="checkbox"/> Lawn <input type="checkbox"/> Oil field water <input type="checkbox"/> Other | | |
| | | | 9. Casing: Material <u>PVC</u> Height: <u>Above</u> or below Threaded <input type="checkbox"/> Welded <input type="checkbox"/> Surface <u>24</u> in. RMP <input type="checkbox"/> PVC <u>Blue</u> Weight <u>2.74</u> lbs./ft. Dia. <u>5</u> in. to <u>80</u> ft. depth Wall Thickness: inches or Dia. <u>5</u> in. to <u>80</u> ft. depth gage No. <u>.258</u> | | |
| | | | 10. Screen: Manufacturer's name <u>Pumco</u> Type <u>PVC</u> Dia. <u>5"</u> Size/gauge <u>20</u> Length <u>20'</u> Set between <u>50</u> ft. and <u>70</u> ft. Gravel pack? <u>Yes</u> Size range of material <u>1/4 X 1/8</u> | | |
| | | | 11. Static water level: <u>40</u> ft. below land surface Date <u>8-14-78</u> mo./day/yr. | | |
| | | | 12. Pumping level below land surfaces: <u>Air Test</u> <u> </u> ft. after <u> </u> hrs. pumping <u> </u> g.p.m. <u> </u> ft. after <u> </u> hrs. pumping <u> </u> g.p.m. Estimated maximum yield <u>10</u> g.p.m. | | |
| | | | 13. Water sample submitted: <u> </u> mo./day/yr. <input type="checkbox"/> Yes <input checked="" type="checkbox"/> No Date <u> </u> | | |
| | | | 14. Well head completion: <u>Top cap</u> <input type="checkbox"/> Pitless adapter <u>24</u> Inches above grade | | |
| | | | 15. Well grouted? <u>Yes</u> With: <input checked="" type="checkbox"/> Neat cement <input type="checkbox"/> Bentonite <input type="checkbox"/> Concrete Depth: From <u>0</u> ft. to <u>10</u> ft. | | |
| | | | 16. Nearest source of possible contamination: ft. <u>200</u> Direction <u>NW</u> Type <u>Lateral</u> Well disinfected upon completion? <input checked="" type="checkbox"/> Yes <input type="checkbox"/> No | | |
| | | | 17. Pump: <input checked="" type="checkbox"/> Not installed Manufacturer's name <u> </u> Model number <u> </u> HP <u> </u> Volts <u> </u> Length of drop pipe <u> </u> ft. capacity <u> </u> g.p.m. Type: <input type="checkbox"/> Submersible <input type="checkbox"/> Turbine <input type="checkbox"/> Jet <input type="checkbox"/> Reciprocating <input type="checkbox"/> Centrifugal <input type="checkbox"/> Other | | |
| | | | 20. Water well contractor's certification: This well was drilled under my jurisdiction and this report is true to the best of my knowledge and belief. <u>Strader Dalg Co Inc 182</u> Business name License No. Address <u>RTI Holton, KS</u> Signed <u>Dale Ashen</u> Date <u>8-15-78</u> Authorized representative | | |
| 18. Elevation: | | 19. Remarks: <u>owner to install slab</u> | | | |
| Topography: <input type="checkbox"/> Hill <input type="checkbox"/> Slope <input checked="" type="checkbox"/> Upland <input type="checkbox"/> Valley | | | | | |

T 9 22 W 9 SE SE NE
R
Sec 9