


WATER WELL RECORD Form WWC-5 KSA 82a-1212

1 LOCATION OF WATER WELL: County Leavenworth Fraction NW 1/4 NE 1/4 SW 1/4 Section Number 9 Township Number T 9 S S Range Number R 22 E EW

Distance and direction from nearest town or city street address of well if located within city?
1/2 mile east city of Lansing, KS

2 WATER WELL OWNER: Roy Wiley
 RR#, St. Address, Box # : R #5 Box 294 Board of Agriculture, Division of Water Resources
 City, State, ZIP Code : Leavenworth, KS 66048 Application Number:

3 LOCATE WELL'S LOCATION WITH AN "X" IN SECTION BOX:

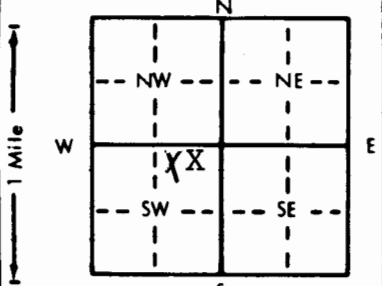

4 DEPTH OF COMPLETED WELL 120' ft. ELEVATION:

Depth(s) Groundwater Encountered 1. 55 ft. 2. 60 ft. 3. 6-30-91 ft.
 WELL'S STATIC WATER LEVEL 60 ft. below land surface measured on mo/day/yr
 Pump test data: Well water was 02 ft. after 8 1/2 hours pumping 120 gpm
 Est. Yield 02 gpm Well water was 12 ft. after 20 hours pumping 120 gpm
 Bore Hole Diameter 12 in. to 20 ft., and 8 1/2 in. to 120 ft.
 WELL WATER TO BE USED AS:
 * (7) Domestic) 3 Feedlot 6 Oil field water supply 9 Dewatering 12 Other (Specify below)
 2 Irrigation 4 Industrial 7 Lawn and garden only 10 Monitoring well
 Was a chemical/bacteriological sample submitted to Department? Yes No X; If yes, mo/day/yr sample was submitted No X

5 TYPE OF BLANK CASING USED: #2
 1 Steel 3 RMP (SR) 5 Wrought iron 8 Concrete tile CASING JOINTS: Glued X Clamped
 (2 PVC) 4 ABS 6 Asbestos-Cement 9 Other (specify below) Welded
 7 Fiberglass Threaded

Blank casing diameter 5 in. to 120 ft., Dia. 120 in. to 265 ft., Dia. 160 psi
 Casing height above land surface 12' in., weight 284 lbs./ft. Wall thickness or gauge No. 265 160 psi

TYPE OF SCREEN OR PERFORATION MATERIAL:
 1 Steel 3 Stainless steel 5 Fiberglass * (7 PVC) 10 Asbestos-cement
 2 Brass 4 Galvanized steel 6 Concrete tile 8 RMP (SR) 11 Other (specify)
 SCREEN OR PERFORATION OPENINGS ARE: #8
 1 Continuous slot 3 Mill slot 5 Gauzed wrapped 8 Saw cut 11 None (open hole)
 2 Louvered shutter 4 Key punched 6 Wire wrapped 9 Drilled holes
 7 Torch cut 10 Other (specify)

SCREEN-PERFORATED INTERVALS: From 80 ft. to 90 ft., From 110 ft. to 120 ft., From 20 ft. to 120 ft.

GRAVEL PACK INTERVALS: From 20 ft. to 120 ft., From 20 ft. to 120 ft., From 20 ft. to 120 ft.

6 GROUT MATERIAL: 1 Neat cement *2 Cement grout 3 Bentonite 4 Other
 Grout Intervals: From 03 ft. to 20 ft., From 20 ft. to 120 ft., From 20 ft. to 120 ft.

What is the nearest source of possible contamination: #1
 * 1 Septic tank 4 Lateral lines 7 Pit privy 10 Livestock pens 14 Abandoned water well
 2 Sewer lines 5 Cess pool 8 Sewage lagoon 11 Fuel storage 15 Oil well/Gas well
 3 Watertight sewer lines 6 Seepage pit 9 Feedyard 12 Fertilizer storage 16 Other (specify below)
 13 Insecticide storage
 Direction from well? SE How many feet? 180

FROM	TO	LITHOLOGIC LOG	FROM	TO	PLUGGING INTERVALS
0	3	Top Soil			
3	17	Clay			
17	45	Shale			
45	75	Sandy Shale			
75	98	Sandstone			
98	120	Shale			

7 CONTRACTOR'S OR LANDOWNER'S CERTIFICATION: This water well was (*) constructed, (2) reconstructed, or (3) plugged under my jurisdiction and was completed on (mo/day/year) 8-30-91 and this record is true to the best of my knowledge and belief. Kansas Water Well Contractor's License No. 174 This Water Well Record was completed on (mo/day/yr) 10-15-91 under the business name of Breuer Inc by (signature) John S Breuer

INSTRUCTIONS: Use typewriter or ball point pen. PLEASE PRESS FIRMLY and PRINT clearly. Please fill in blanks, underline or circle the correct answers. Send top three copies to Kansas Department of Health and Environment, Bureau of Water, Topeka, Kansas 66620-0001. Telephone: 913-296-5545. Send one to WATER WELL OWNER and retain one for your records.