


1 LOCATION OF WATER WELL: Fraction SE 1/4 NW 1/4 NE 1/4 Section Number 12 Township Number T 9 S Range Number R 22 EW

Distance and direction from nearest town or city street address of well if located within city? E-END OF MONTANA CT E of 4TH - LEAVENWORTH

2 WATER WELL OWNER: CITY OF LEAVENWORTH ATT: MICHAEL G. McDONALD Board of Agriculture, Division of Water Resources RR#, St. Address, Box #: 100 N 5TH - LEAVENWORTH KS 66048 Application Number:

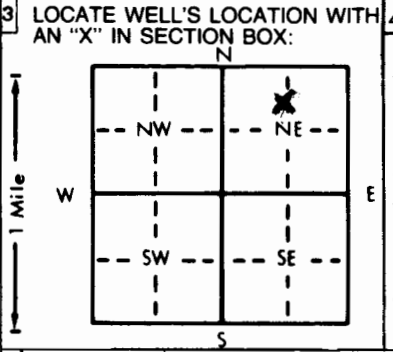

3 LOCATE WELL'S LOCATION WITH AN 'X' IN SECTION BOX: DEPTH OF COMPLETED WELL 20 ft. ELEVATION: 14 ft. WELL'S STATIC WATER LEVEL 6.68 ft. below land surface measured on mo/day/yr 07-07-94

5 TYPE OF BLANK CASING USED: 1 Steel, 2 PVC, 3 RMP (SR), 4 ABS, 5 Wrought iron, 6 Asbestos-Cement, 7 Fiberglass, 8 Concrete tile, 9 Other (specify below), 10 Asbestos-cement, 11 Injection well, 12 Other (Specify below)

SCREEN OR PERFORATION MATERIAL: 1 Steel, 2 Brass, 3 Stainless steel, 4 Galvanized steel, 5 Fiberglass, 6 Concrete tile, 7 PVC, 8 RMP (SR), 9 ABS, 10 Asbestos-cement, 11 Other (specify), 12 None used (open hole)

6 GROUT MATERIAL: 1 Neat cement, 2 Cement grout, 3 Bentonite, 4 Other. Grout Intervals: From 64 ft. to 7 ft., From 3 ft. to 7 ft., From 9 ft. to 9 ft.

Table with columns: FROM, TO, LITHOLOGIC LOG, FROM, TO, PLUGGING INTERVALS. Entry: 6L TO 5, SILTY CLAY CONCRETE TRASH; 5 TO 20, SILTY CLAY; TD TO 20.

7 CONTRACTOR'S OR LANDOWNER'S CERTIFICATION: This water well was (1) constructed, (2) reconstructed, or (3) plugged under my jurisdiction and was completed on (mo/day/year) 06-21-94 and this record is true to the best of my knowledge and belief. Kansas Water Well Contractor's License No. 479 This Water Well Record was completed on (mo/day/yr) 07-15-94 under the business name of EBBERTS DRILLING by (signature) Angus Ebberts

OFFICE USE ONLY

T

R

EW

SEC.

1/4

1/4

1/4