


1 LOCATION OF WATER WELL: County: LEAVENWORTH Fraction: SE 1/4 NW 1/4 NE 1/4 Section Number: 12 Township Number: T 9 S Range Number: R 22 E/W

Distance and direction from nearest town or city street address of well if located within city? 3107 S 4TH LEAVENWORTH

2 WATER WELL OWNER: OLYMPIC CAR WASH ATT DON GRAY RR#, St. Address, Box # 3107 S 4TH LEAVENWORTH KS 66048 Board of Agriculture, Division of Water Resources Application Number:

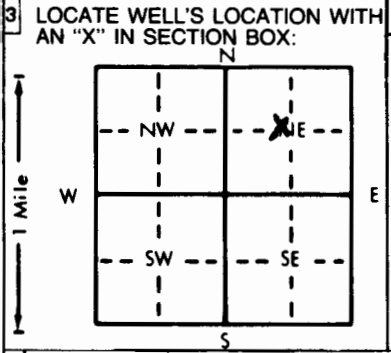

3 LOCATE WELL'S LOCATION WITH AN 'X' IN SECTION BOX: 4 DEPTH OF COMPLETED WELL: 15 ft. ELEVATION: 15 ft. 8.5 ft. WELL'S STATIC WATER LEVEL: 6.82 ft. below land surface measured on mo/day/yr 07-07-94

5 TYPE OF BLANK CASING USED: 1 Steel, 2 PVC, 3 RMP (SR), 4 ABS, 5 Wrought iron, 6 Asbestos-Cement, 7 Fiberglass, 8 Concrete tile, 9 Other (specify below), 10 Asbestos-cement, 11 Other (specify), 12 None used (open hole). SCREEN OR PERFORATION MATERIAL: 1 Steel, 2 Brass, 3 Stainless steel, 4 Galvanized steel, 5 Fiberglass, 6 Concrete tile, 7 PVC, 8 RMP (SR), 9 ABS, 10 Asbestos-cement, 11 Other (specify), 12 None used (open hole).

6 GROUT MATERIAL: 1 Neat cement, 2 Cement grout, 3 Bentonite, 4 Other. Grout Intervals: From 6 ft. to 2 ft., From 3 ft. to 4 ft. What is the nearest source of possible contamination: 1 Septic tank, 2 Sewer lines, 3 Watertight sewer lines, 4 Lateral lines, 5 Cess pool, 6 Seepage pit, 7 Pit privy, 8 Sewage lagoon, 9 Feedyard, 10 Livestock pens, 11 Fuel storage, 12 Fertilizer storage, 13 Insecticide storage, 14 Abandoned water well, 15 Oil well/Gas well, 16 Other (specify below). CONTAMINATED SITE

Table with columns: FROM, TO, LITHOLOGIC LOG, FROM, TO, PLUGGING INTERVALS. Row 1: 6L, 5, FILL - SD. GRAVEL - CLAY, (blank), (blank). Row 2: 5, 15, SILTY CLAY, (blank), (blank). Row 3: TD, 15, (blank), (blank), (blank).

7 CONTRACTOR'S OR LANDOWNER'S CERTIFICATION: This water well was (1) constructed, (2) reconstructed, or (3) plugged under my jurisdiction and was completed on (mo/day/year) 06-20-94 and this record is true to the best of my knowledge and belief. Kansas Water Well Contractor's License No. 479 This Water Well Record was completed on (mo/day/yr) 07-15-94 under the business name of EBERTS DRILLING by (signature) Megan Eberts

OFFICE USE ONLY

T

R

EW

SEC.

1/4

1/4

1/4