


1103

1 LOCATION OF WATER WELL: Fraction SE 1/4 NW 1/4 NE 1/4 Section Number 12 Township Number T 9 S Range Number R 22 EW  
 County: LEAVENWORTH

Distance and direction from nearest town or city street address of well if located within city?  
3111 S 4TH - LEAVENWORTH

2 WATER WELL OWNER: CARI'S GAS SERVICE ATT. FRED ZUCH JR  
 RR#, St. Address, Box #: 3111 S 4TH LEAVENWORTH KS 66048  
 City, State, ZIP Code: 3111 S 4TH LEAVENWORTH KS 66048  
 Board of Agriculture, Division of Water Resources  
 Application Number:

3 LOCATE WELL'S LOCATION WITH AN "X" IN SECTION BOX:

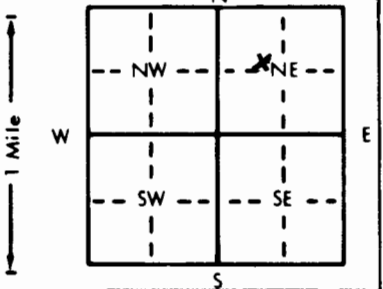

4 DEPTH OF COMPLETED WELL: 15 ft. ELEVATION: \_\_\_\_\_

Depth(s) Groundwater Encountered 1. 4.6 ft. 2. \_\_\_\_\_ ft. 3. \_\_\_\_\_ ft.

WELL'S STATIC WATER LEVEL 4.13 ft. below land surface measured on mo/day/yr 07-07-94

Pump test data: Well water was \_\_\_\_\_ ft. after \_\_\_\_\_ hours pumping \_\_\_\_\_ gpm

Est. Yield \_\_\_\_\_ gpm: Well water was \_\_\_\_\_ ft. after \_\_\_\_\_ hours pumping \_\_\_\_\_ gpm

Bore Hole Diameter 8.625 in. to 15 ft. and \_\_\_\_\_ in. to \_\_\_\_\_ ft.

WELL WATER TO BE USED AS: 5 Public water supply 8 Air conditioning 11 Injection well

1 Domestic 3 Feedlot 6 Oil field water supply 9 Dewatering 12 Other (Specify below)

2 Irrigation 4 Industrial 7 Lawn and garden only 10 Monitoring well \_\_\_\_\_

Was a chemical/bacteriological sample submitted to Department? Yes \_\_\_\_\_ No X; If yes, mo/day/yr sample was submitted

Water Well Disinfected? Yes \_\_\_\_\_ No X

5 TYPE OF BLANK CASING USED: 5 Wrought iron 8 Concrete tile CASING JOINTS: Glued \_\_\_\_\_ Clamped \_\_\_\_\_

1 Steel 3 RMP (SR) 6 Asbestos-Cement 9 Other (specify below) Welded \_\_\_\_\_

2 PVC 4 ABS 7 Fiberglass \_\_\_\_\_ Threaded X

Blank casing diameter 2 in. to 4.3 ft. Dia \_\_\_\_\_ in. to \_\_\_\_\_ ft. Dia \_\_\_\_\_ in. to \_\_\_\_\_ ft.

Casing height above land surface FLUSH in. weight SC40 lbs./ft. Wall thickness or gauge No. \_\_\_\_\_

TYPE OF SCREEN OR PERFORATION MATERIAL: 7 PVC 10 Asbestos-cement

1 Steel 3 Stainless steel 5 Fiberglass 8 RMP (SR) 11 Other (specify) \_\_\_\_\_

2 Brass 4 Galvanized steel 6 Concrete tile 9 ABS 12 None used (open hole)

SCREEN OR PERFORATION OPENINGS ARE: 5 Gauzed wrapped 8 Saw cut 11 None (open hole)

1 Continuous slot 3 Mill slot 6 Wire wrapped 9 Drilled holes \_\_\_\_\_

2 Louvered shutter 4 Key punched 7 Torch cut 10 Other (specify) \_\_\_\_\_

SCREEN-PERFORATED INTERVALS: From 4.3 ft. to 14.3 ft. From \_\_\_\_\_ ft. to \_\_\_\_\_ ft.

From \_\_\_\_\_ ft. to \_\_\_\_\_ ft. From \_\_\_\_\_ ft. to \_\_\_\_\_ ft.

SAND GRAVEL PACK INTERVALS: From 3.3 ft. to 15 ft. From \_\_\_\_\_ ft. to \_\_\_\_\_ ft.

From \_\_\_\_\_ ft. to \_\_\_\_\_ ft. From \_\_\_\_\_ ft. to \_\_\_\_\_ ft.

6 GROUT MATERIAL: 1 Neat cement 2 Cement grout 3 Bentonite 4 Other \_\_\_\_\_

Grout Intervals: From GL ft. to 1.5 ft. From 1.5 ft. to 3.3 ft. From \_\_\_\_\_ ft. to \_\_\_\_\_ ft.

What is the nearest source of possible contamination: 10 Livestock pens 14 Abandoned water well

1 Septic tank 4 Lateral lines 7 Pit privy 11 Fuel storage 15 Oil well/Gas well

2 Sewer lines 5 Cess pool 8 Sewage lagoon 12 Fertilizer storage 16 Other (specify below)

3 Watertight sewer lines 6 Seepage pit 9 Feedyard 13 Insecticide storage CONTAMINATED SITE

Direction from well? \_\_\_\_\_ How many feet? \_\_\_\_\_

| FROM      | TO        | LITHOLOGIC LOG        | FROM | TO | PLUGGING INTERVALS |
|-----------|-----------|-----------------------|------|----|--------------------|
| <u>GL</u> | <u>1</u>  | <u>ASPHALT-GRAVEL</u> |      |    |                    |
| <u>1</u>  | <u>14</u> | <u>SILTY CLAY</u>     |      |    |                    |
| <u>14</u> | <u>15</u> | <u>CLAY</u>           |      |    |                    |
| <u>TD</u> | <u>15</u> |                       |      |    |                    |

7 CONTRACTOR'S OR LANDOWNER'S CERTIFICATION: This water well was (1) constructed, (2) reconstructed, or (3) plugged under my jurisdiction and was completed on (mo/day/year) 06-20-94 and this record is true to the best of my knowledge and belief. Kansas

Water Well Contractor's License No. 479 This Water Well Record was completed on (mo/day/yr) 07-15-94

under the business name of EBBERTS DRILLING by (signature) Angie Ebberts