

206

R

USE TYPEWRITER OR BALL POINT PEN-PRESS FIRMLY, PRINT CLEARLY.


WATER WELL RECORD
KSA 82a-1201-1215

Kansas Department of Health and Environment-Division of Environment
(Water well Contractors)
Topeka, Kansas 66620

16

1. Location of well: County **Leavenworth** Fraction ~~NW~~ ^{NE} ~~SW~~ ^{NE} ~~SE~~ ^{SW} Section number **15** Township number T **9** S R Range number **22** ^W

2. Distance and direction from nearest town or city:
Street address of well location if in city:
3. Owner of well: **Mr. Charles Patton**
R.R. or street: **1009 N. 13th**
City, state, zip code: **Leavenworth, Kansas 66048**

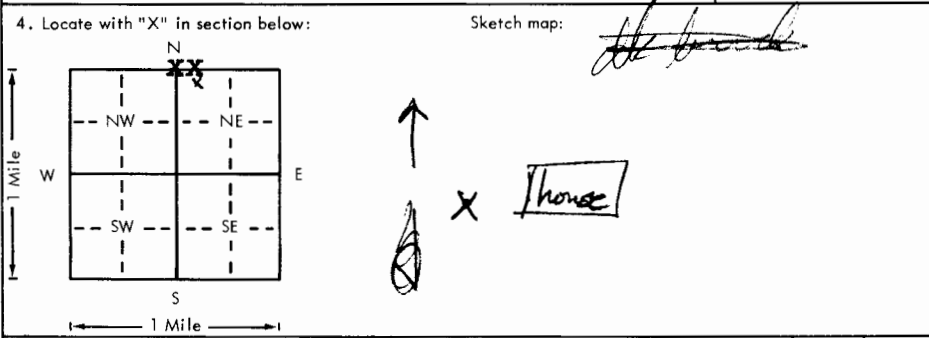

6. Bore hole dia. **8** in. Completion date **11-13-78**
Well depth **140** ft.
7. Cable tool Rotary Driven Dug
 Hollow rod Jetted Bored Reverse rotary
8. Use: Domestic Public supply Industry
 Irrigation Air conditioning Stock
 Lawn Oil field water Other
9. Casing: Material **PL.** Height: Above or below
Threaded Welded Surface **18** in.
RMP PVC Weight _____ lbs./ft.
Dia. **5** in. to **141** ft. depth Wall Thickness: inches or
Dia. _____ in. to _____ ft. depth gage No. **265**

5. Type and color of material	From	To
Fill & Top Soil	0	5
Clay	5	20
Lime	20	22
Lime & Sandstone	22	27
Sandstone - Yellow	27	52
Sandstone - Gray	52	121
Sandy Shale	121	140
(Use a second sheet if needed)		

10. Screen: Manufacturer's name **Vinylplex, Inc.** (Slotted Pipe)
Type **PVC** Dia. **5"**
Slot/gauze **.06 1/16** Length **40'**
Set between **120** ft. and **140** ft.
60 ft. and **80** ft.
Gravel pack? Size range of material **1/4 - 1/8**
11. Static water level: _____ mo./day/yr.
50 ft. below land surface Date **11-13-78**
12. Pumping level below land surfaces:
_____ ft. after _____ hrs. pumping _____ g.p.m.
_____ ft. after _____ hrs. pumping _____ g.p.m.
Estimated maximum yield **6** g.p.m.
13. Water sample submitted: _____ mo./day/yr.
 Yes No Date _____
14. Well head completion: Pitless adapter **18** Inches above grade
15. Well grouted? **Yes**
With: Neat cement Bentonite Concrete
Depth: From **3** ft. to **15** ft.
16. Nearest source of possible contamination:
ft. **250** Direction **west** Type **Septic**
Well disinfected upon completion? Yes No
17. Pump: Not installed
Manufacturer's name **Jacuzzi**
Model number **7S4B** HP **3/4** Volts **220**
Length of drop pipe **130** ft. capacity **10** g.p.m.
Type:
 Submersible Turbine
 Jet Reciprocating
 Centrifugal Other

18. Elevation: **97**
Topography:
 Hill
 Slope
 Upland
 Valley

19. Remarks:

20. Water well contractor's certification:
This well was drilled under my jurisdiction and this report is true to the best of my knowledge and belief.
BREUER, INC. **174**
Business name _____ License No. _____
Address **Box 147, Basehor, Ks.**
Signed *[Signature]* Date **11-13-78**

Forward the white, blue and pink copies to the Department of Health and Environment

Form WWC-5

BR elev = 950
▽ = 922

9
22
15
NW
SE
1/4
1/4
1/4
1/4