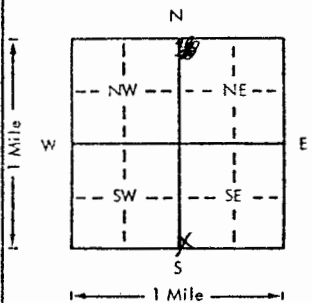


202

USE TYPEWRITER OR BALL POINT PEN-PRESS FIRMLY, PRINT CLEARLY.

WATER WELL RECORD
KSA 82a-1201-1215

Kansas Department of Health and Environment-Division of Environment (Water well Contractors) Topeka, Kansas 66620

1. Location of well: County: Leavenworth		Fraction: SW SW SE NE 1/4 NW 1/4 NE 1/4		Section number: 21	Township number: 9	Range number: 22	
2. Distance and direction from nearest town or city: Street address of well location if in city: 2 miles south of Leavenworth, Kansas				3. Owner of well: Mr. Doyle Morrison R.R. or street: Route 3 Box 2000C City, state, zip code: Leavenworth, Kansas			
4. Locate with "X" in section below: Sketch map: 				6. Bore hole dia. 8 in. Completion date: 10-4-77 Well depth _____ ft.			
5. Type and color of material				7. <input checked="" type="checkbox"/> Cable tool <input checked="" type="checkbox"/> Rotary <input type="checkbox"/> Driven <input type="checkbox"/> Dug <input type="checkbox"/> Hollow rod <input type="checkbox"/> Jetted <input type="checkbox"/> Bored <input type="checkbox"/> Reverse rotary			
Top Soil				8. Use: <input checked="" type="checkbox"/> Domestic <input type="checkbox"/> Public supply <input type="checkbox"/> Industry <input type="checkbox"/> Irrigation <input type="checkbox"/> Air conditioning <input type="checkbox"/> Stock <input type="checkbox"/> Lawn <input type="checkbox"/> Oil field water <input type="checkbox"/> Other			
Clay				9. Casing: Material PVC Height: Above or below Threaded _____ Welded <input checked="" type="checkbox"/> Surface _____ 18 in. RMP _____ PVC <input checked="" type="checkbox"/> Weight _____ lbs./ft. Dia. 5 in. to 101 ft. depth Wall Thickness, inches or Dia. _____ in. to _____ ft. depth Gage No. 265			
Sandstone				10. Screen: Manufacturer's name (Slotted Pipe) Type PVC Dia. 5" Slot/gauze .06 1/16 Length 80' Set between 60 ft. and 80 ft. 20 ft. and 40 ft. Gravel pack? <input checked="" type="checkbox"/> Size range of material 1/4 - 1/8			
Sandy Shale				11. Static water level: _____ mo./day/yr. 25 ft. below land surface Date 10-4-77			
				12. Pumping level below land surfaces: _____ ft. after _____ hrs. pumping _____ g.p.m. _____ ft. after _____ hrs. pumping _____ g.p.m. Estimated maximum yield 5 g.p.m.			
				13. Water sample submitted: _____ mo./day/yr. <input type="checkbox"/> Yes <input checked="" type="checkbox"/> No Date _____			
				14. Well head completion: <input checked="" type="checkbox"/> Pitless adapter 18 inches above grade			
				15. Well grouted? <input checked="" type="checkbox"/> Yes With: <input checked="" type="checkbox"/> Neat cement <input type="checkbox"/> Benjonite <input type="checkbox"/> Concrete Depth: From 3 ft. to 15 ft.			
				16. Nearest source of possible contamination: _____ ft. 75' Direction north Type septic Well disinfected upon completion? <input checked="" type="checkbox"/> Yes <input type="checkbox"/> No			
				17. Pump: <input checked="" type="checkbox"/> Not installed Manufacturer's name _____ Model number _____ HP _____ Volts _____ Length of drop pipe _____ ft. capacity _____ g.p.m. Type: <input type="checkbox"/> Submersible <input type="checkbox"/> Turbine <input type="checkbox"/> Jet <input type="checkbox"/> Reciprocating <input type="checkbox"/> Centrifugal <input type="checkbox"/> Other			
(Use a second sheet if needed)							
18. Elevation: 947		19. Remarks:		20. Water well contractor's certification: This well was drilled under my jurisdiction and this report is true to the best of my knowledge and belief. BREUER, INC. 174 Business name License No. Address Box 117, Basehor, Ks. 66007 Signed [Signature] Date 10-5-77			
Topography: <input type="checkbox"/> Hill <input type="checkbox"/> Slope <input type="checkbox"/> Upland <input type="checkbox"/> Valley							

Forward the white, blue and pink copies to the Department of Health and Environment

Form WWC-5

BR elev = 929
D = 917

CF