

VBRT
part of land

KANSAS WELL SCHEDULE

Card 1

Record by: Kliaschmidt 7-5-73 Date: 7-5-73 Project: Top-KC State: Kan K County: Leaw 52

Latitude: _____ Longitude: _____ Accuracy: _____ Owner's well no: _____

Location: NE SE no. sec. 29, T. 9 N., R. 22 E. Well number: 922E29EAB

Owner: Loren Steiner name address RR³ Leavenworth

Owner: LOREN STEINER Altitude: 1050 Accuracy: _____

Driller: _____ Date drilled: 5-5-72

Topography, well site: (D) Draw, (F) flood plain, (L) lowland, (R) rolling, (S) slope, (T) terrace, (U) upland Spring; or depth of well: 100 feet 100 accuracy 3

Diameter: 6" inches 06 Depth cased: 100 feet 100 Spring, or Csg. type: Plastic Finish: _____ Lift & power: _____

Pump setting: _____ Use of well: Domestic Stock, irrigation, industrial, public supply, observation, none, test _____

Water level: 6.05 feet above 605 below _____ accuracy 1 date measured _____ Water level records avail. _____

Description MP: Top casing 1.0 above yard above _____ below _____

Yield: _____ gpm 5 accuracy 3 Pumping period: _____ hours or days _____ Specific capacity: _____ gpm/ft. dd _____

Pumpage and other data available: _____

Card 2

Coefficient trans: _____ gpd/ft _____ Coefficient storage: _____ Coefficient perm.: _____ gpd/ft².

Aquifer, system or series _____

Aquifer, units _____

Aquifer, thickness: _____ feet _____ Aquifer, length of well open to: _____ feet _____ Aquifer, depth to top of: _____ feet _____ Aquifer, origin: _____

Aquifer, lithology of: _____

Bedrock, system: _____ Bedrock, formation: _____ Bedrock, depth to: _____ feet _____

Surficial material: _____ lithology _____ infiltration characteristics _____ Log data avail: _____

Quality of water data available: _____ Temperature of water: _____ °F. _____ Date sampled: _____

Coefficient of leakage: _____

THE FOLLOWING DATA ARE USED ON THE NATIONAL WELL SCHEDULE

Ownership category: (C) County, (F) Federal Gov't., (M) City, (N) Corp. or Co., (P) Private, (S) State Agency, (W) Water Dist. _____ P

Method drilled: (A) Air, (B) bored, (C) cable, (D) dug, (V) driven, (H) hyd. rotary, (J) jetted, (R) rev. rotary, (T) trenching, (S) spring, _____ H

Physiographic province: _____ Section: _____

Drainage basin: _____ Subbasin: _____ Depth to basement: _____ source of data (basement) _____

Quadrangle: _____ Well no. _____

10.00
2.95
7.05
-1
6.05


Well no.				
Well log				
Geologic unit	Description of material	Thick-ness	Depth	Remarks

Water Tower

Well 300' →
← 200' →

Highway

North

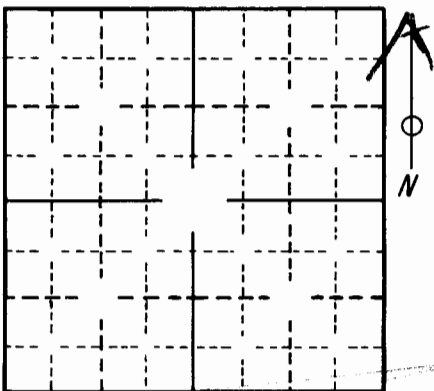

Highway