


1 LOCATION OF WATER WELL: Leavenworth County:	Fraction NE $\frac{1}{4}$ SE $\frac{1}{4}$ NE $\frac{1}{4}$	Section Number 2	Township Number 9	Range Number 22	EW
--	--	----------------------------	-----------------------------	---------------------------	-----------

Distance and direction from nearest town or city street address of well if located within city?
10th Street and Pennsylvania, Leavenworth Kansas

2 WATER WELL OWNER: Steve's Apco	RR #, St. Address, Box #: Manufactures State BAnk 1700 10th Street City, State, ZIP Code : Leavenworth, Ks
	Board of Agriculture, Division of Water Resources Application Number:

3 MARK WELL'S LOCATION WITH AN "X" IN SECTION BOX:	4 DEPTH OF WELL 12 ft. WELL'S STATIC WATER LEVEL .. 9.25 ft. WELL WAS USED AS: <table style="width:100%; border: none;"> <tr> <td style="width:33%;">1 Domestic</td> <td style="width:33%;">5 Public Water Supply</td> <td style="width:33%;">9 Dewatering</td> </tr> <tr> <td>2 Irrigation</td> <td>6 Oil Field Water Supply</td> <td><input checked="" type="radio"/> 10 Monitoring Well</td> </tr> <tr> <td>3 Feedlot</td> <td>7 Domestic (Lawn & Garden)</td> <td>11 Injection Well</td> </tr> <tr> <td>4 Industrial</td> <td>8 Air Conditioning</td> <td>12 Other</td> </tr> </table> <p>Was a chemical / bacteriological sample submitted to Department? Yes No <input checked="" type="checkbox"/> If yes, mo/day/yr sample was submitted</p> <p>Water Well Disinfected: Yes No <input checked="" type="checkbox"/></p>	1 Domestic	5 Public Water Supply	9 Dewatering	2 Irrigation	6 Oil Field Water Supply	<input checked="" type="radio"/> 10 Monitoring Well	3 Feedlot	7 Domestic (Lawn & Garden)	11 Injection Well	4 Industrial	8 Air Conditioning	12 Other
1 Domestic	5 Public Water Supply	9 Dewatering											
2 Irrigation	6 Oil Field Water Supply	<input checked="" type="radio"/> 10 Monitoring Well											
3 Feedlot	7 Domestic (Lawn & Garden)	11 Injection Well											
4 Industrial	8 Air Conditioning	12 Other											

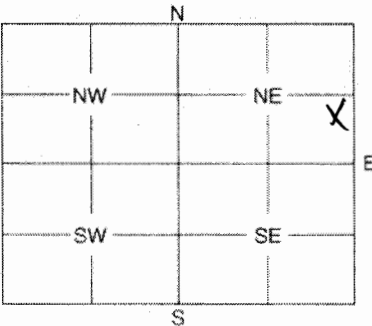

5 TYPE OF BLANK CASING USED:	<table style="width:100%; border: none;"> <tr> <td>1 Steel</td> <td>3 RMP (SR)</td> <td>5 Wrought</td> <td>7 Fiberglass</td> <td>9 Other (Specify below)</td> </tr> <tr> <td><input checked="" type="radio"/> 2 PVC</td> <td>4 ABS</td> <td>6 Asbestos-Cement</td> <td>8 Concrete Tile</td> <td></td> </tr> </table> <p>Blank casing diameter 2 in. Was casing pulled? Yes No <input checked="" type="checkbox"/> If yes, how much</p> <p>Casing height above or below land surface in.</p>	1 Steel	3 RMP (SR)	5 Wrought	7 Fiberglass	9 Other (Specify below)	<input checked="" type="radio"/> 2 PVC	4 ABS	6 Asbestos-Cement	8 Concrete Tile	
1 Steel	3 RMP (SR)	5 Wrought	7 Fiberglass	9 Other (Specify below)							
<input checked="" type="radio"/> 2 PVC	4 ABS	6 Asbestos-Cement	8 Concrete Tile								

6 GROUT PLUG MATERIAL:	<table style="width:100%; border: none;"> <tr> <td>1 Neat cement</td> <td>2 Cement grout</td> <td><input checked="" type="radio"/> 3 Bentonite</td> <td><input checked="" type="radio"/> 4 Other Surface silts/clays</td> </tr> </table> <p>Grout Plug Intervals: From 3 to 12 ft. to 5 ft. From 5 ft. to 0 ft. From to ft.</p> <p>What is the nearest source of possible contamination:</p> <table style="width:100%; border: none;"> <tr> <td>1 Septic tank</td> <td>6 Seepage pit</td> <td>11 Fuel storage</td> <td><input checked="" type="radio"/> 16 Other (specify below)</td> </tr> <tr> <td>2 Sewer lines</td> <td>7 Pit privy</td> <td>12 Fertilizer storage</td> <td>Cont. site</td> </tr> <tr> <td>3 Watertight sewer lines</td> <td>8 Sewage lagoon</td> <td>13 Insecticide storage</td> <td></td> </tr> <tr> <td>4 Lateral lines</td> <td>9 Feedyard</td> <td>14 Abandoned water well</td> <td></td> </tr> <tr> <td>5 Cess pool</td> <td>10 Livestock pens</td> <td>15 Oil well/Gas well</td> <td></td> </tr> </table> <p>Direction from well? How many feet?</p>	1 Neat cement	2 Cement grout	<input checked="" type="radio"/> 3 Bentonite	<input checked="" type="radio"/> 4 Other Surface silts/clays	1 Septic tank	6 Seepage pit	11 Fuel storage	<input checked="" type="radio"/> 16 Other (specify below)	2 Sewer lines	7 Pit privy	12 Fertilizer storage	Cont. site	3 Watertight sewer lines	8 Sewage lagoon	13 Insecticide storage		4 Lateral lines	9 Feedyard	14 Abandoned water well		5 Cess pool	10 Livestock pens	15 Oil well/Gas well	
1 Neat cement	2 Cement grout	<input checked="" type="radio"/> 3 Bentonite	<input checked="" type="radio"/> 4 Other Surface silts/clays																						
1 Septic tank	6 Seepage pit	11 Fuel storage	<input checked="" type="radio"/> 16 Other (specify below)																						
2 Sewer lines	7 Pit privy	12 Fertilizer storage	Cont. site																						
3 Watertight sewer lines	8 Sewage lagoon	13 Insecticide storage																							
4 Lateral lines	9 Feedyard	14 Abandoned water well																							
5 Cess pool	10 Livestock pens	15 Oil well/Gas well																							

FROM	TO	PLUGGING MATERIALS
12	.5	Bentonite grout
.5	0	Surface silts/clays

7 CONTRACTOR'S OF LANDOWNER'S CERTIFICATION: This water well was plugged under my jurisdiction and was completed on (mo/day/year) 11/22/06 and this record is true to the best of my knowledge and belief. Kansas Water Well Contractor's License No. 585 This Water Well Record was completed on (mo/day/year) 12/22/06 under the business name of Associated Environmental, Inc. by (signature) B. Johnson

INSTRUCTIONS: Use typewriter or ball point pen. Please press firmly and print clearly. Please fill in blanks, underline or circle the correct answers. Send top three copies to Kansas Department of Health and Environment, Bureau of Water, Geology Section, 1000 SW Jackson St., Ste. 420, Topeka, Kansas 66612-1367. Telephone: 785/296-5522. Send one to Water Well Owner and retain one for your records.