


|  |   |                            |                                 |                               |
|--|---|----------------------------|---------------------------------|-------------------------------|
| 1 LOCATION OF WATER WELL:<br>County: <b>Leavenworth</b>  | Fraction<br><b>SW</b> ¼ <b>NW</b> ¼ <b>NE</b> ¼ | Section Number<br><b>2</b> | Township Number<br>T <b>9</b> S | Range Number<br>R <b>22</b> E |
| Distance and direction from nearest town or city street address of well if located within city?<br><b>1700 10<sup>th</sup> Avenue, Leavenworth, Kansas</b> |   |                            |                                 |                               |

2 WATER WELL OWNER: **Steve's Apco**  
 RR#, St. Address, Box #: **1700 10<sup>th</sup> Avenue**  
 City, State, ZIP Code: **Leavenworth, Ks**  
 Board of Agriculture, Division of Water Resources  
 Application Number:

3 LOCATE WELL'S LOCATION WITH AN "X" IN SECTION BOX:

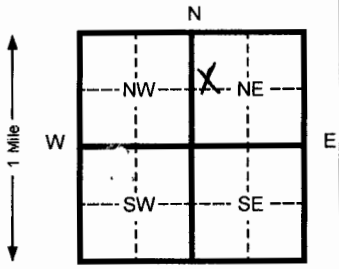

4 DEPTH OF COMPLETED WELL **25** ft. ELEVATION: \_\_\_\_\_  
 Depth(s) Groundwater Encountered 1 \_\_\_\_\_ ft. 2 \_\_\_\_\_ ft. 3 \_\_\_\_\_ ft.  
 WELL'S STATIC WATER LEVEL \_\_\_\_\_ ft. below land surface measured on mo/day/yr  
 Pump test data: Well water was \_\_\_\_\_ Ft. after \_\_\_\_\_ hours pumping \_\_\_\_\_ Gpm  
 Est. Yield \_\_\_\_\_ Gpm Well water was \_\_\_\_\_ Ft. after \_\_\_\_\_ Hours pumping \_\_\_\_\_ Gpm  
 Bore Hole Diameter **8.625** in. to **25** Ft. and \_\_\_\_\_ in. to \_\_\_\_\_ Ft.  
 WELL WATER TO BE USED AS: 5 Public water supply 8 Air conditioning 11 Injection well  
 1 Domestic 3 Feed lot 6 Oil field water supply 9 Dewatering 12 Other (Specify below)  
 2 Irrigation 4 Industrial 7 Lawn and garden (domestic) 10 **Monitoring well MW-8**  
 Was a chemical/bacteriological sample submitted to Department? Yes \_\_\_\_\_ No **X** If yes, mo/day/yr sample was Submitted \_\_\_\_\_  
 Water Well Disinfected? Yes \_\_\_\_\_ No **X**

5 TYPE OF BLANK CASING USED:  
 1 **PVC** 2 Steel 3 RMP (SR) 4 ABS 5 Wrought Iron 6 Asbestos-Cement 7 Fiberglass 8 Concrete tile 9 Other (specify below)  
 CASING JOINTS: Glued \_\_\_\_\_ Clamped \_\_\_\_\_ Welded \_\_\_\_\_ Threaded **X**  
 Blank casing diameter **2** in. to **5** Ft., Dia \_\_\_\_\_ in. to \_\_\_\_\_ ft., Dia \_\_\_\_\_ in. to \_\_\_\_\_ ft.  
 Casing height above land surface **FLUSH** in., weight **SCH 40** Lbs./ft. Wall thickness or gauge No. \_\_\_\_\_  
 TYPE OF SCREEN OR PERFORATION MATERIAL:  
 1 Steel 2 Brass 3 Stainless steel 4 Galvanized steel 5 Fiberglass 6 Concrete tile 7 **PVC** 8 RMP (SR) 9 ABS 10 Asbestos-cement 11 Other (specify) 12 None used (open hole)  
 SCREEN OR PERFORATION OPENINGS ARE:  
 1 Continuous slot 2 Louvered shutter 3 **Mill slot** 4 Key punched 5 Gauzed wrapped 6 Wire wrapped 7 Torch cut 8 Saw cut 9 Drilled holes 11 None (open hole) 10 Other (specify) \_\_\_\_\_  
 SCREEN-PERFORATED INTERVALS: From **5** ft. to **25** ft. From \_\_\_\_\_ ft. to \_\_\_\_\_ ft.  
 SAND PACK INTERVALS: From **3** ft. to **25** ft. From \_\_\_\_\_ ft. to \_\_\_\_\_ ft.

6 GROUT MATERIAL: 1 Neat cement 2 Cement grout 3 **Bentonite** 4 Other \_\_\_\_\_  
 Grout Intervals From **3** Ft. to **1** Ft. to **3** Ft. to **0** Ft. to **1** ft. From \_\_\_\_\_ ft. to \_\_\_\_\_ ft.  
 What is the nearest source of possible contamination:  
 1 Septic tank 2 Sewer lines 3 Watertight sewer lines 4 Lateral lines 5 Cess pool 6 Seepage pit 7 Pit privy 8 Sewage lagoon 9 Feedyard 10 Livestock pens 11 Fuel storage 12 Fertilizer storage 13 Insecticide storage 14 Abandoned water well 15 Oil well/ Gas well 16 **Other (specify below) Contaminated Site**  
 Direction from well? \_\_\_\_\_ How many feet? \_\_\_\_\_

| FROM | TO   | CODE | LITHOLOGIC LOG                 | FROM | TO | PLUGGING INTERVALS |
|------|------|------|--------------------------------|------|----|--------------------|
| 0    | 6    |      | Fill I                         |      |    |                    |
| 6    | 9    |      | Silty clay, brown              |      |    |                    |
| 9    | 12   |      | Silty clay and clayey silt     |      |    |                    |
| 12   | 17   |      | Clayey sugar fine sands tan    |      |    |                    |
| 17   | 20.5 |      | Silty Clays brown              |      |    |                    |
| 20.5 | 25   |      | Silty sand with fine sand/clay |      |    |                    |
| 25   | TD   |      | End of Borehole                |      |    |                    |
|      |      |      |                                |      |    |                    |
|      |      |      |                                |      |    |                    |
|      |      |      |                                |      |    |                    |

7 CONTRACTOR'S OR LANDOWNER'S CERTIFICATION: This water well was (x) constructed, (2) reconstructed, or (3) plugged under my jurisdiction and w  
 Completed on (mo/day/yr) **08/09/07** And this record is true to the best of my knowledge and belief. Kansas  
 Water Well Contractor's License No. **585** This Water Well Record was completed on (mo/day/yr) **09/06/07**  
 under the business name of **Associated Environmental, Inc.** By (signature) **Bradley J. Johnson**

INSTRUCTIONS: Please fill in blanks and circle the correct answers. Send three copies to Kansas Department of Health and Environment, Bureau of Water, Topeka, Kansas 66620-0001. Telephone: 913-296-5545. Send one to WATER WELL OWNER and retain one for your records.

OFFICE USE ONLY

T

R

SEC