

mw13

None


WATER WELL PLUGGING RECORD Form WWC-5P KSA 82a-1212 ID NO.

1 LOCATION OF WATER WELL: Fraction Section Number Township Number Range Number  
County: Leavenworth SE 1/4 SE 1/4 NE 1/4 13 95 22 E/W

Distance and direction from nearest town or city street address of well if located within city?

1205 North main Lansing KS

2 WATER WELL OWNER: Leavenworth CO Global Positioning Systems (decimal degrees, min. of 4 digits  
Latitude: 39.26781  
RR#, St. Address, Box #: COOP 1205 N. main Longitude: -94.90073  
City, State ZIP Code: Lansing KS Elevation: 839.63  
Datum:  
Data Collection Method: Survey

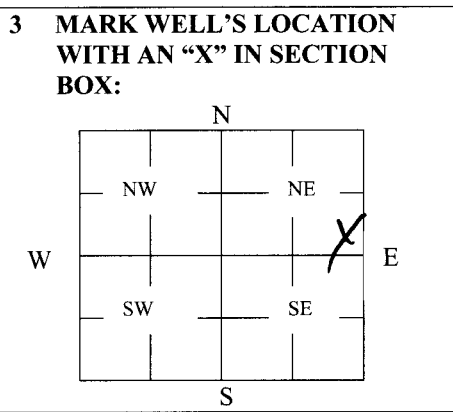

4 DEPTH OF WELL 21 ft.  
WELL'S STATIC WATER LEVEL 9.81 ft  
WELL WAS USED AS:  
1 Domestic 5 Public Water Supply 9 Dewatering  
2 Irrigation 6 Oil Field Water Supply 10 Monitoring  
3 Feedlot 7 Domestic (Lawn & Garden) 11 Injection Well  
4 Industrial 8 Air Conditioning 12 Other  
Was a chemical/bacteriological sample submitted to Department? Yes No X

5 TYPE OF BLANK CASING USED:  
1 Steel 3 RMP (SR) 5 Wrought 7 Fiberglass 9 Other (Specify below)  
2 PVC 4 ABS 6 Asbestos-Cement 8 Concrete Tile  
Blank casing diameter 2 in. Was casing pulled? Yes X No If yes, how much 3'  
Casing height above or below land surface 36 in.

6 GROUT PLUG MATERIAL: 1 Neat cement 2 Cement grout 3 Bentonite 4 Other  
Grout Plug Intervals: From 21 ft. to 1 ft., From ft. to ft., From to ft.  
What is the nearest source of possible contamination:  
1 Septic tank 6 Seepage pit 11 Fuel Storage 16 Other (specify below) USTS  
2 Sewer lines 7 Pit privy 12 Fertilizer storage  
3 Watertight sewer lines 8 Sewage lagoon 13 Insecticide storage  
4 Lateral lines 9 Feedyard 14 Abandoned water well Direction from well? East  
5 Cess pool 10 Livestock pens 15 Oil well/Gas well How many feet?

FROM	TO	PLUGGING MATERIALS	FROM	TO	PLUGGING MATERIALS
21	1	Bentonite Chips			

7 CONTRACTOR'S OR LANDOWNER'S CERTIFICATION: This water well was plugged under my jurisdiction and was completed on (mo/day/year) 10/16/09 and this record is true to the best of my knowledge and belief. Kansas Water Well Contractor's License No. This Water Well Record was completed on (mo/day/year) 10/23/09 under the business name of Tank Management Services by (signature)

INSTRUCTIONS: Use typewriter or ballpoint pen. Please press firmly and print clearly. Please fill in blanks, underline or circle the correct answers. Send top three copies to Kansas Department of Health and Environment, Bureau of Water, Geology Section, 1000 SW Jackson St., Ste. 420, Topeka, Kansas 66612-1367. Telephone: 785/296-5522. Send one to Water Well Owner and retain one for your records. Visit us at http://www.kdheks.gov/geo/waterwells.