

**WATER WELL PLUGGING RECORD Form WWC-5P** KSA 82a-1212 ID NO.  


**1 LOCATION OF WATER WELL:** Fraction SE 1/4 NE 1/4 SE 1/4 Section Number 35 Township Number T 9 S Range Number 32  E  W

Street/Rural Address of Well Location; if unknown, distance & direction from nearest town or intersection: If at owner's address, check here  14517 147th

**Global Positioning Systems (GPS) information:**  
 Latitude: 39° 13' 46.84" N (in decimal degrees)  
 Longitude: 94° 55' 10.03" W (in decimal degrees)  
 Elevation: 285 meters  
 Datum:  WGS84,  NAD83,  NAD27

**2 WATER WELL OWNER:** School Dist  
 RR#, St. Address, Box #: USD 469  
 City, State ZIP Code:

**Collection Method:**  
 GPS unit (Make/Model: \_\_\_\_\_)  
 Digital Map/Photo,  Topographic Map,  Land Survey  
 Est. Accuracy:  < 3 m,  3-5 m,  5-15 m,  > 15 m

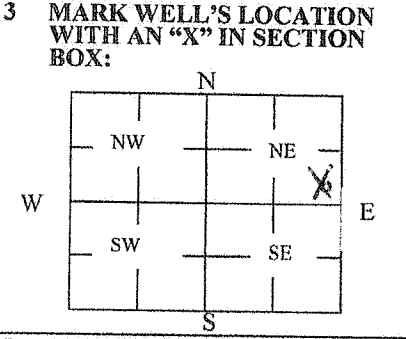

**4 DEPTH OF WELL** 60 ft.  
 WELL'S STATIC WATER LEVEL 50 ft.  
 WELL WAS USED AS:  
 Domestic  Public Water Supply  Dewatering  
 Irrigation  Oil Field Water Supply  Monitoring  
 Feedlot  Domestic (Lawn & Garden)  Injection Well  
 Industrial  Air Conditioning  Other \_\_\_\_\_  
 Was a chemical/bacteriological sample submitted to Department? Yes  No

**5 TYPE OF BLANK CASING USED:**  
 Steel  RMP (SR)  Wrought  Fiberglass  Other (Specify below)  
 PVC  ABS  Asbestos-Cement  Concrete Tile Hand dug (Rock)  
 Blank casing diameter 36 in. Was casing pulled? Yes  No  If yes, how much \_\_\_\_\_  
 Casing height above or below land surface \_\_\_\_\_ in.

**6 GROUT PLUG MATERIAL:**  Neat cement  Cement grout  Bentonite  Other \_\_\_\_\_  
 Grout Plug Intervals: From 10 ft. to 8 ft., From \_\_\_\_\_ ft. to \_\_\_\_\_ ft., From \_\_\_\_\_ to \_\_\_\_\_ ft.


What is the nearest source of possible contamination:  
 Septic tank  Seepage pit  Fuel Storage  Other (specify below) \_\_\_\_\_  
 Sewer lines  Pit privy  Fertilizer storage \_\_\_\_\_  
 Watertight sewer lines  Sewage lagoon  Insecticide storage \_\_\_\_\_  
 Lateral lines  Feedyard  Abandoned water well Direction from well? \_\_\_\_\_  
 Cess pool  Livestock pens  Oil well/Gas well How many feet? \_\_\_\_\_

FROM	TO	PLUGGING MATERIALS	FROM	TO	PLUGGING MATERIALS
60	40	Clean Gravel/sand			
40	10	Clay			
10	8	Bentonite/Grout			
8	0	Top Soil			

**7 CONTRACTOR'S OR LANDOWNER'S CERTIFICATION:** This water well was plugged under my jurisdiction and was completed on (mo/day/year) 5/18/13 and this record is true to the best of my knowledge and belief. Kansas Water Well Contractor's License No. 630. This Water Well Record was completed on (mo/day/year) 5/30/13 under the business name of Digger Jim by (signature) James C. [Signature]

**INSTRUCTIONS:** Use typewriter or ballpoint pen. Please press firmly and print clearly. Please fill in blanks, underline or circle the correct answers. Send top three copies to Kansas Department of Health and Environment, Bureau of Water, Geology Section, 1000 SW Jackson St., Ste. 420, Topeka, Kansas 66612-1367. Telephone: 785/296-5524. Send one to Water Well Owner and retain one for your records. Visit us at <http://www.kdheks.gov/waterwell/index.html>.

Check one:  White Copy  Blue Copy  Pink Copy

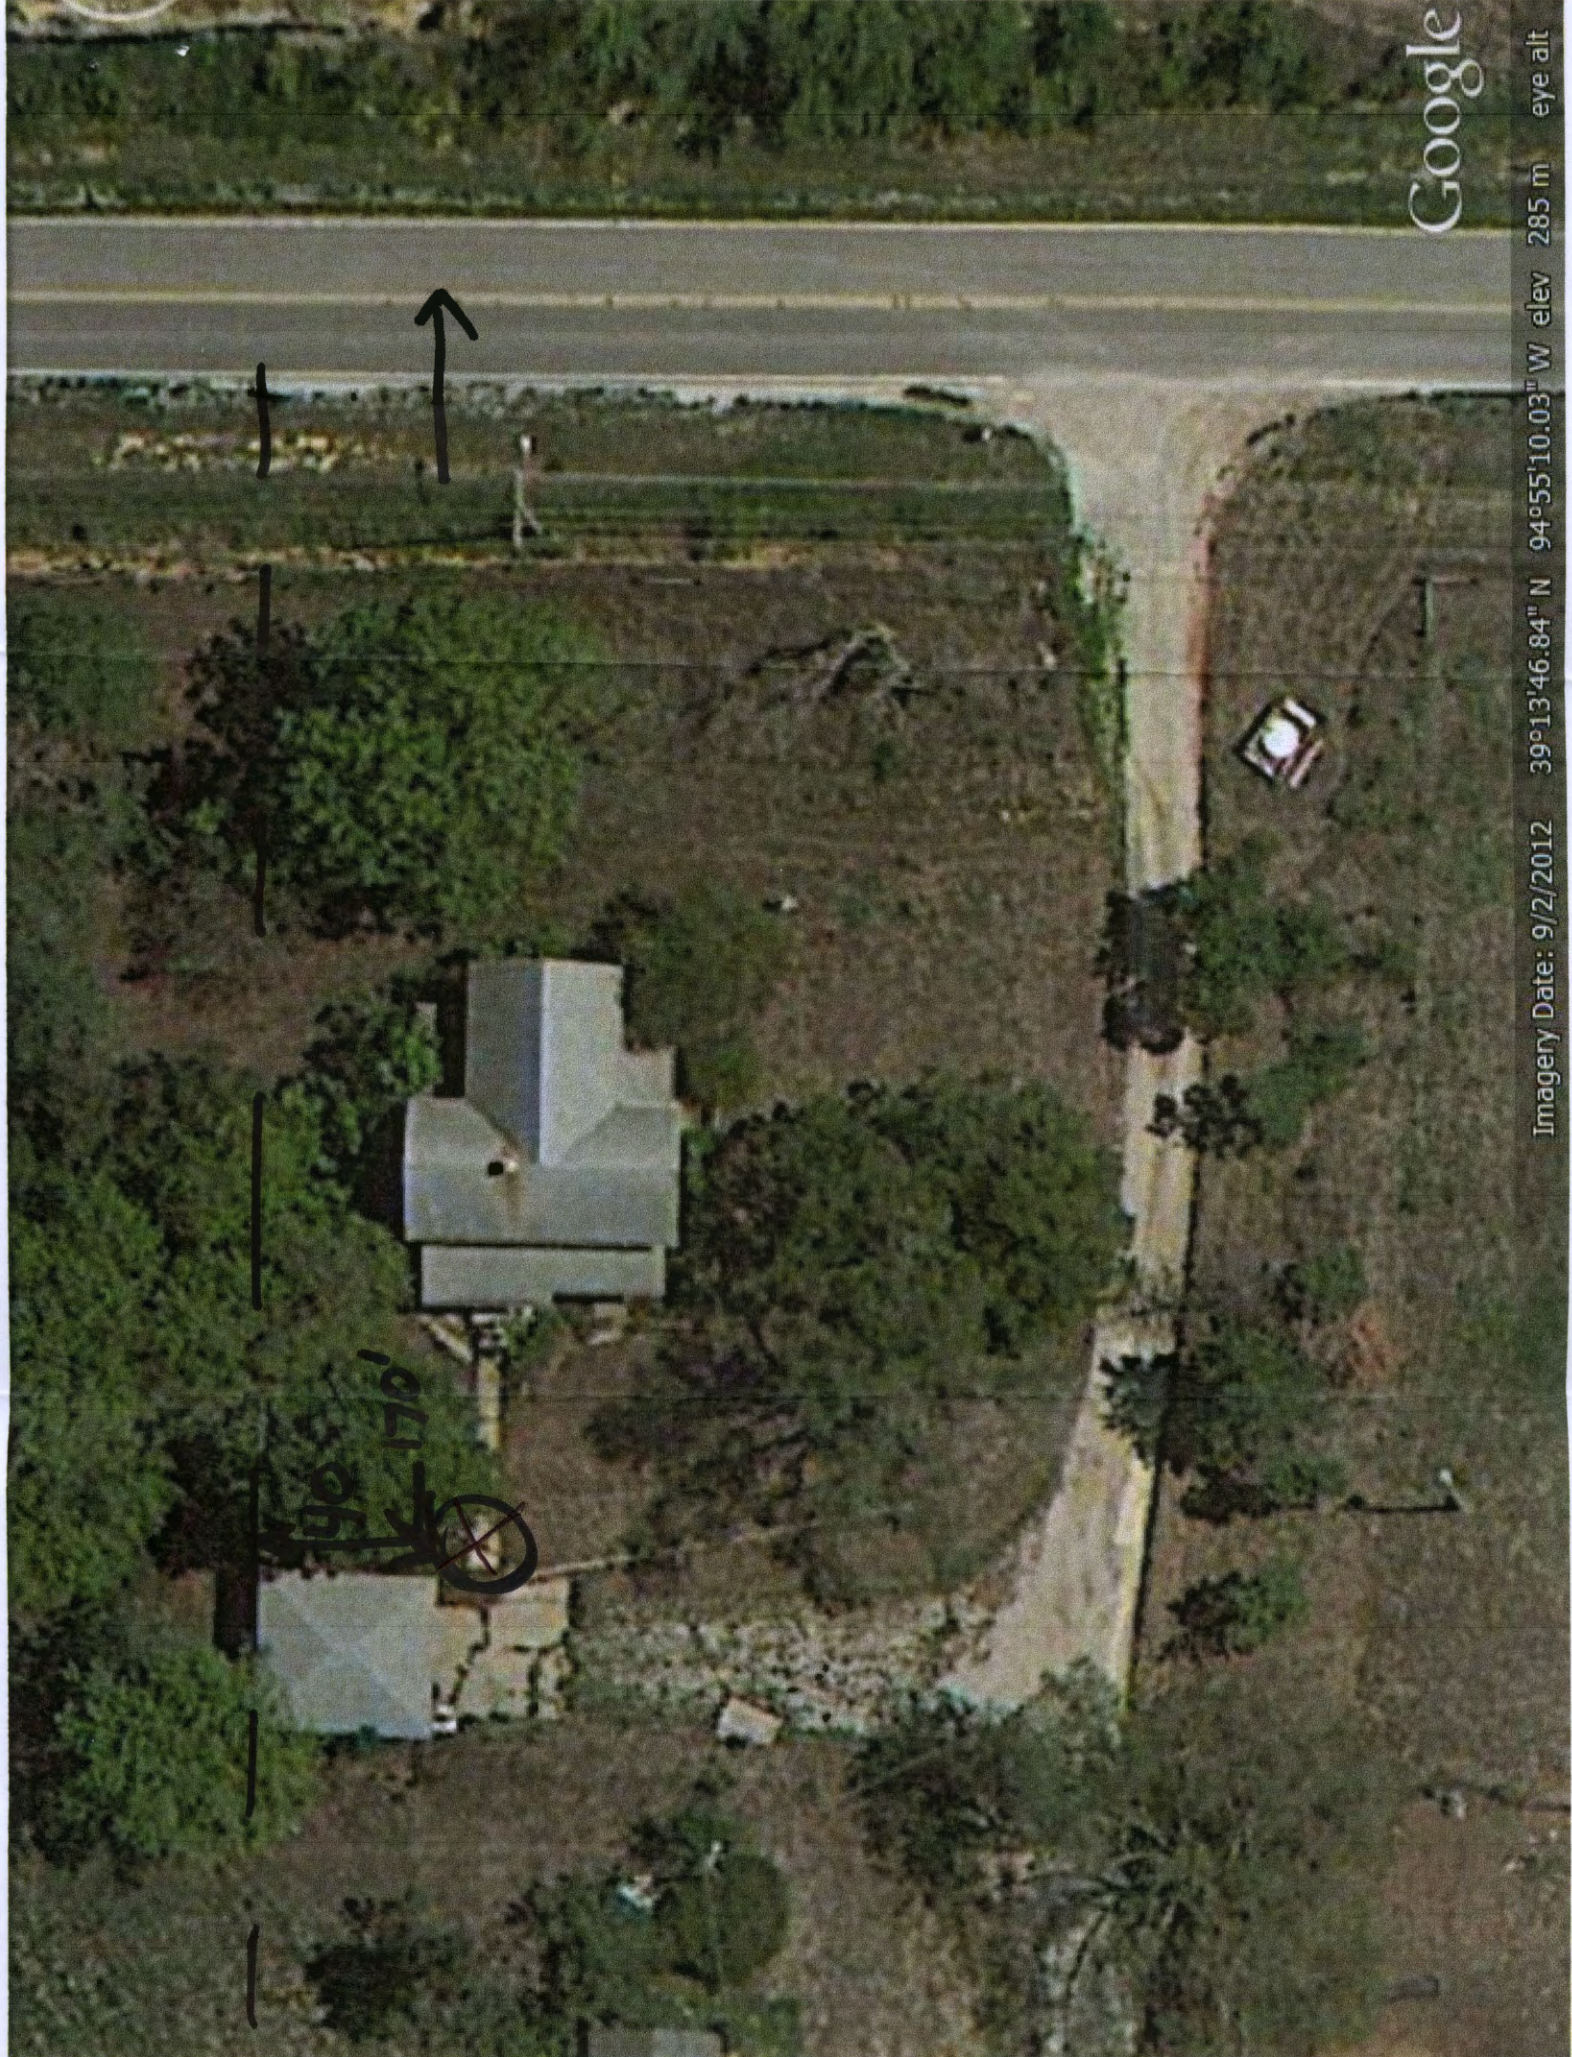

Google

Imagery Date: 9/2/2012 39°13'46.84" N 94°55'10.03" W elev 285 m eye alt