
		Correction		VWC-5 e in Well Use			of Water App. No.		Well ID	MW-9		
		VATER WEI		Fraction			Number	Township Numb		ge Number		
Count	_{y:} Leavenv	vorth		SW 1/4 SE 1/4 SW 1/4	NE 1/4		1 T 9 S R 22 E U W					
2 WELL OWNER: Last Name: Business: City of Leavenworth First: Street or Rural Address where well is located (if unknown, distance and direction from nearest town or intersection): If at owner's address, check here:												
	Address 100 N Eth Street							S. 3rd Street, Leavenworth, Ks.				
Address:	1/0											
dec. (dec. (dec.) dec. (dec.)										(decimal degrees)		
	ON BOX:			Encountered: 1)1			Longitude:					
1	2) ft. 3) WELL'S STATIC WATER LEVEI							Latitude/Longitude		83 🛯 NAD 27		
		below l	land surface, measured on (mo-day-yr). 2-20-2			023		unit make/model:				
\square above land surface			measured on (mo-day-yr)			(WAAS enabled? ☐ Yes ☐ No)						
			ater was ft.			■ Land Survey □ Topographic Map □ Online Mapper:						
W	Well w			ater was f				е Маррег:				
after hours			pumping gpm			(File effect 776.81 a) E C al 1 = 700						
S Bore Hole Diameter			gpm			6 Elevation: .776.81 Ground Level TOC Source: Land Survey GPS Topographic Map						
	Bore Hole Diameter:			3.75 in. to20 ft. and in. to ft.								
7 WELL WATER TO BE USED AS:												
	1. Domestic: 5. □ Public Water Supply: well ID 10. □ Oil Field Water Supply: lease											
	Household 6. Dewatering:				how many wells?			11. Test Hole: well ID				
	□ Lawn & Garden 7. □ Aquifer Recharge: w □ Livestock 8. ■ Monitoring: well III				MW-9 12 Case			d 🔲 Uncased 🗌 Geotechnical mal: how many bores?				
2. 🗌 Irrigati								Loop Horizont				
				Soil Vapor E					e Discharge 🔲 Inj. of Water			
4. Industrial Recovery Injection 13. Other (specify):								-				
Was a chemical/bacteriological sample submitted to KDHE? 🗌 Yes 🔳 No If yes, date sample was submitted:												
Water well disinfected? Ves No												
8 TYPE OF CASING USED: Steel PVC Other CASING JOINTS: Glued Clamped Welded Threaded Casing diameter												
Casing height above land surface												
TYPE OF SCREEN OR PERFORATION MATERIAL:												
□ Steel □ Stainless Steel □ Fiberglass ■ PVC □ Other (Specify)												
Brass Galvanized Steel Concrete tile None used (open hole)												
SCREEN OR PERFORATION OPENINGS ARE: ☐ Continuous Slot												
Louvered Shutter Key Punched Wire Wrapped Saw Cut None (Open Hole)												
SCREEN-I	PERFORAT	TED INTERV	ALS: From		ft., Froi	n	ft. to	ft., From	ft. to	ft.		
GRAVEL PACK INTERVALS: From												
9 GROUT MATERIAL: Neat cement Cement grout Bentonite Other Cement pad												
Grout Intervals: From												
Septic Tank Lateral Lines Pit Privy Livestock Pens Insecticide Storage												
□ Sewer Lines □ Cess Pool □ Sewage Lagoon ■ Fuel Storage □ Abandoned Water Well												
□ Watertight Sewer Lines □ Seepage Pit □ Feedyard □ Fertilizer Storage □ Oil Well/Gas Well □ Other (Specify) .contaminated site												
Direction from well?												
10 FROM	TO		ITHOLOG	SIC LOG	FROM	T	O LII	HO. LOG (cont.) or	PLUGGIN	GINTERVALS		
0	0.5	Asphalt & G										
0.5 2.5	2.5 8			st, trace sand & gra								
8	10			an, trace sand & gr bist, trace gravel, hy								
<u> </u>	10	carbon odor		nst, trace graver, ny								
10	15			ay, soft, wet to satu								
		very slight petroleum odor Notes						and the second se				
15	20	Silty Clay, dark gray, soft, wet to saturated										
slight hydrocarbon odor												
11 CONTRACTOR'S OR LANDOWNER'S CERTIFICATION: This water well was constructed, reconstructed, or plugged under my jurisdiction and was completed on (mo-day-year) .2-14-2023 and this record is true to the best of my knowledge and belief.												
Kansas Water Well Contractor's License No. 604												
under the b	usiness nan	ne of Enviror	imental Pi	tiority Service, inc.		Signatu	re PA	JA.				
Mail 1 white copy along with a fee of \$5.00 for each constructed well to: Kansas Department of Health and Environment, Bureau of Water, GWTS Section, 1000 SW Jackson St., Suite 420, Topeka, Kansas 66612-1367. Mail one to Water Well Owner and retain one for your records. Telephone 785-296-5524.												
Visit us at http://www.kdheks.gov/waterwell/index.html KSA 82a-1212 Revised 7/10/2015												

Path: D:\Mat E\blackstone-env.com\GIS - DATABASE\KDHE LKRBCA\KDHE LKRBCA6.aprx



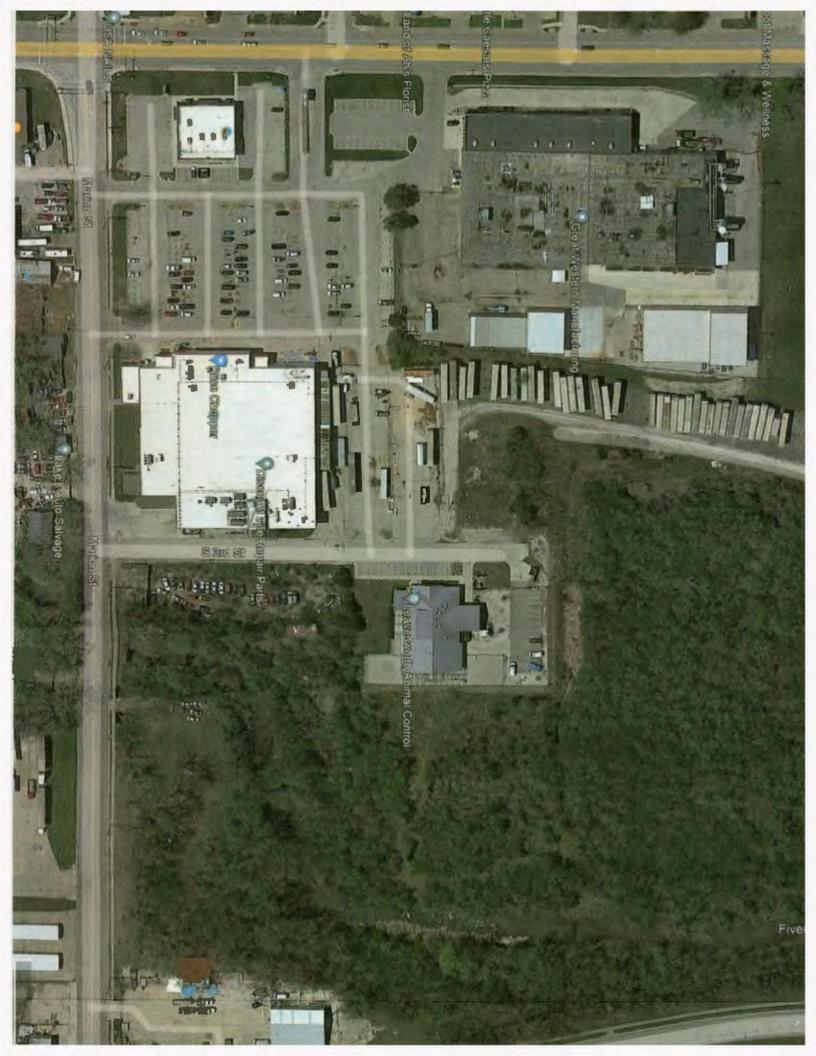

- 2 box of 2×10 screen, 10 slot - 2 box of 2x10 riser - 10 2" J plug - 5 male 2" threaded end 5 female - B H& wood plugs - 72 bags 12-20 sond - pallet of bentonite - 8 8x12 flush mounts - 21 drums

RECEIVED APR. 1 & 2023 BUREAU OF WATER

KS GEOFOGICAT SUBAEA INT 18 5053 BECEIAED