


1 LOCATION OF WATER WELL: County: Leavenworth Fraction: SE 1/4 NW 1/4 NE 1/4 Section Number: 12 Township Number: T 9 S Range Number: R 22 E/W

Distance and direction from nearest town or city street address of well if located within city? 3111 S. 4th St, Leavenworth

2 WATER WELL OWNER: Leavenworth Plaza
 RR#, St. Address, Box #: 4801 Johnson Dr.
 City, State, ZIP Code: MISSION, KS 66205
 Board of Agriculture, Division of Water Resources
 Application Number:

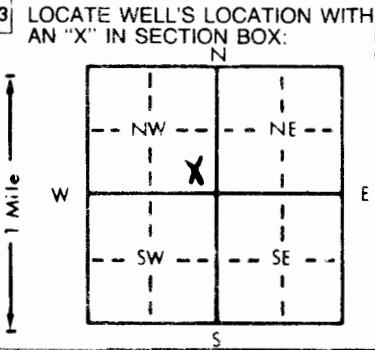

4 DEPTH OF COMPLETED WELL: 20 ft. ELEVATION:
 Depth(s) Groundwater Encountered 1. 8-? ft. 2. - ft. 3. - ft.
 WELL'S STATIC WATER LEVEL: 8 ft. below land surface measured on mo/day/yr
 Pump test data: Well water was - ft. after - hours pumping - gpm
 Est. Yield - gpm: Well water was - ft. after - hours pumping - gpm
 Bore Hole Diameter: 8.625 in. to 20 ft., and - in. to - ft.
 WELL WATER TO BE USED AS:
 5 Public water supply 8 Air conditioning 11 Injection well
 1 Domestic 3 Feedlot 6 Oil field water supply 9 Dewatering 12 Other (Specify below)
 2 Irrigation 4 Industrial 7 Lawn and garden only 10 Monitoring well
 Was a chemical/bacteriological sample submitted to Department? Yes - No X If yes, mo/day/yr sample was submitted -
 Water Well Disinfected? Yes - No X

5 TYPE OF BLANK CASING USED:
 1 Steel 3 RMP (SR) 5 Wrought iron 8 Concrete tile CASING JOINTS: Glued - Clamped -
 2 PVC 4 ABS 6 Asbestos-Cement 9 Other (specify below) Welded -
 7 Fiberglass Threaded X
 Blank casing diameter: 2 in. to 10 ft., Dia - in. to - ft., Dia - in. to - ft.
 Casing height above land surface: FLUSH in., weight SCH 40 lbs./ft. Wall thickness or gauge No. -
 TYPE OF SCREEN OR PERFORATION MATERIAL:
 1 Steel 3 Stainless steel 5 Fiberglass 7 PVC 10 Asbestos-cement
 2 Brass 4 Galvanized steel 6 Concrete tile 8 RMP (SR) 11 Other (specify) -
 9 ABS 12 None used (open hole)
 SCREEN OR PERFORATION OPENINGS ARE:
 1 Continuous slot 3 Mill slot 5 Gauzed wrapped 8 Saw cut 11 None (open hole)
 2 Louvered shutter 4 Key punched 6 Wire wrapped 9 Drilled holes
 7 Torch cut 10 Other (specify) -
 SCREEN-PERFORATED INTERVALS: From 10 ft. to 20 ft., From - ft. to - ft., From - ft. to - ft.
 From - ft. to - ft., From - ft. to - ft., From - ft. to - ft.
 SAND GRAVEL PACK INTERVALS: From 6 ft. to 20 ft., From - ft. to - ft., From - ft. to - ft.
 From - ft. to - ft., From - ft. to - ft., From - ft. to - ft.

6 GROUT MATERIAL: 1 Neat cement 2 Cement grout 3 Bentonite 4 Other -
 Grout Intervals: From 2 ft. to 4 ft., From 3 ft. to 4 ft., From 6 ft. to - ft., From - ft. to - ft.
 What is the nearest source of possible contamination:
 1 Septic tank 4 Lateral lines 7 Pit privy 11 Fuel storage 14 Abandoned water well
 2 Sewer lines 5 Cess pool 8 Sewage lagoon 12 Fertilizer storage 15 Oil well/Gas well
 3 Watertight sewer lines 6 Seepage pit 9 Feedyard 13 Insecticide storage 16 Other (specify below) TANKS REMOVED
 Direction from well? 250' SE - CARLS GAS SERVICE How many feet? CONTAMINATED SITE

FROM	TO	LITHOLOGIC LOG	FROM	TO	PLUGGING INTERVALS
<u>6</u>	<u>2</u>	<u>SOIL</u>			
<u>2</u>	<u>8</u>	<u>SILTY CLAY - BROWN</u>			
<u>8</u>	<u>16</u>	<u>SILTY CLAY - MOTTLED GREY-TAN</u>			
<u>16</u>	<u>18</u>	<u>CLAY SILT</u>			
<u>18</u>	<u>20</u>	<u>SHALE</u>			
<u>TO</u>	<u>20</u>				

FLUSH MOUT WAIVER
DON TAYLOR 6-22-94

7 CONTRACTOR'S OR LANDOWNER'S CERTIFICATION: This water well was (1) constructed, (2) reconstructed, or (3) plugged under my jurisdiction and was completed on (mo/day/year) 07-07-94 and this record is true to the best of my knowledge and belief. Kansas Water Well Contractor's License No. 479 This Water Well Record was completed on (mo/day/yr) 08-12-94 under the business name of EBBERTS DRILLING by (signature) Susan Ebbert

OFFICE USE ONLY