


1 LOCATION OF WATER WELL: Fraction NW 1/4 SE 1/4 NW 1/4 Section Number 7 Township Number T 9 S Range Number R 22 EW
 County: LEAVENWORTH

Distance and direction from nearest town or city street address of well if located within city?
 1825 S. 4th ST. LEAVENWORTH KS.

2 WATER WELL OWNER: GNB INC MW 710
 RR#, St. Address, Box #: 1825 S. 4th ST Board of Agriculture, Division of Water Resources
 City, State, ZIP Code: LEAVENWORTH KS Application Number: NA

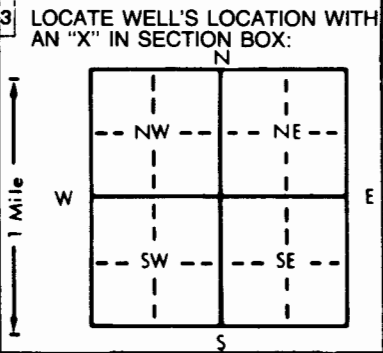

4 DEPTH OF COMPLETED WELL: 43.5 ft. ELEVATION: _____ ft.
 Depth(s) Groundwater Encountered 1. 20.1 ft. 2. _____ ft. 3. _____ ft.
 WELL'S STATIC WATER LEVEL 17.5 ft. below land surface measured on mo/day/yr 8-3-91
 Pump test data: Well water was NA ft. after NA hours pumping _____ gpm
 Est. Yield _____ gpm: Well water was NA ft. after NA hours pumping _____ gpm
 Bore Hole Diameter 17 in. to 27.5 ft., and 9 in. to 43.5 ft.
 WELL WATER TO BE USED AS: 5 Public water supply 8 Air conditioning 11 Injection well
 1 Domestic 3 Feedlot 6 Oil field water supply 9 Dewatering 12 Other (Specify below)
 2 Irrigation 4 Industrial 7 Lawn and garden only 10 Monitoring well
 Was a chemical/bacteriological sample submitted to Department? Yes _____ No If yes, mo/day/yr sample was submitted _____
 Water Well Disinfected? Yes _____ No

5 TYPE OF BLANK CASING USED: 5 Wrought iron 8 Concrete tile CASING JOINTS: Glued _____ Clamped _____
 1 Steel 3 RMP (SR) 6 Asbestos-Cement 9 Other (specify below) Welded _____
 2 PVC 4 ABS 7 Fiberglass Threaded
 Blank casing diameter 10 in. to 27.5 ft. 2" in. to 38.5 ft. Dia _____ in. to _____ ft.
 Casing height above land surface _____ in., weight _____ lbs./ft. Wall thickness or gauge No. 5 in 40
 TYPE OF SCREEN OR PERFORATION MATERIAL: 7 PVC 10 Asbestos-cement
 1 Steel 3 Stainless steel 5 Fiberglass 8 RMP (SR) 11 Other (specify) _____
 2 Brass 4 Galvanized steel 6 Concrete tile 9 ABS 12 None used (open hole)
 SCREEN OR PERFORATION OPENINGS ARE: 5 Gauzed wrapped 8 Saw cut 11 None (open hole)
 1 Continuous slot 3 Mill slot 6 Wire wrapped 9 Drilled holes
 2 Louvered shutter 4 Key punched 7 Torch cut 10 Other (specify) _____
 SCREEN-PERFORATED INTERVALS: From 43.5 ft. to 38.5 ft., From _____ ft. to _____ ft.
 From _____ ft. to _____ ft., From _____ ft. to _____ ft.
 GRAVEL PACK INTERVALS: From 43.5 ft. to 35.8 ft., From _____ ft. to _____ ft.
 From _____ ft. to _____ ft., From _____ ft. to _____ ft.

6 GROUT MATERIAL: 1 Neat cement 2 Cement grout 3 Bentonite 4 Other Cement/Bentonite
 Grout Intervals: 4 From 31.5 ft. to 8 ft. 3 From 35.8 ft. to 31.5 ft. From _____ ft. to _____ ft.
 What is the nearest source of possible contamination: 10 Livestock pens 14 Abandoned water well
 1 Septic tank 4 Lateral lines 7 Pit privy 11 Fuel storage 15 Oil well/Gas well
 2 Sewer lines 5 Cess pool 8 Sewage lagoon 12 Fertilizer storage 16 Other (specify below)
 3 Watertight sewer lines 6 Seepage pit 9 Feedyard 13 Insecticide storage GNB INC.

Direction from well? _____ How many feet? _____

FROM	TO	LITHOLOGIC LOG	FROM	TO	PLUGGING INTERVALS
0	1.5	Gravel, Brick, Concrete			
1.5	3.5	Sandy, Silty clay			
3.5	43.5	Silty clay			
SEE ATTACHED LOGS					

7 CONTRACTOR'S OR LANDOWNER'S CERTIFICATION: This water well was (1) constructed, (2) reconstructed, or (3) plugged under my jurisdiction and was completed on (mo/day/year) 8-1-91 and this record is true to the best of my knowledge and belief. Kansas Water Well Contractor's License No. 735448-3 This Water Well Record was completed on (mo/day/yr) 8-25-91 under the business name of BURLINGTON ENVIRONMENTAL INC by (signature) KET Schaffner