


1 LOCATION OF WATER WELL: County: Leavenworth Fraction: NW 1/4 SE 1/4 NW 1/4 Section Number: 4 Township Number: T 9 S Range Number: R 22 EW

Distance and direction from nearest town or city street address of well if located within city?
1825 S. 4th ST. Leavenworth KS

2 WATER WELL OWNER: G.N.B. INC. Board of Agriculture, Division of Water Resources
 RR#, St. Address, Box #: 1825 S. 4th ST Application Number: NA
 City, State, ZIP Code: Leavenworth KS

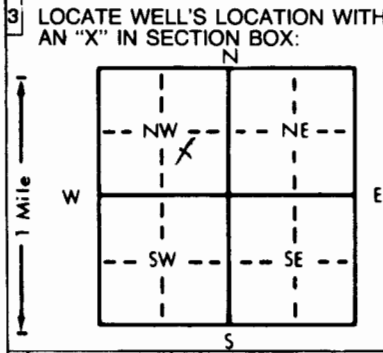

4 DEPTH OF COMPLETED WELL: 44.7 ft. ELEVATION:
 Depth(s) Groundwater Encountered 1. 35 ft. 2. _____ ft. 3. _____ ft.
 WELL'S STATIC WATER LEVEL: 10.6 ft. below land surface measured on mo/day/yr 8-3-94
 Pump test data: Well water was _____ ft. after _____ hours pumping _____ gpm
 Est. Yield _____ gpm Well water was _____ ft. after _____ hours pumping _____ gpm
 Bore Hole Diameter: 17 in. to 25.5 in. and 9 in. to 44.7 in.
 WELL WATER TO BE USED AS:
 5 Public water supply 8 Air conditioning 11 Injection well
 1 Domestic 3 Feedlot 6 Oil field water supply 9 Dewatering 12 Other (Specify below)
 2 Irrigation 4 Industrial 7 Lawn and garden only 10 Monitoring well
 Was a chemical/bacteriological sample submitted to Department? Yes _____ No X If yes, mo/day/yr sample was submitted _____
 Water Well Disinfected? Yes _____ No X

5 TYPE OF BLANK CASING USED:
 1 Steel 3 RMP (SR) 5 Wrought iron 8 Concrete tile CASING JOINTS: Glued _____ Clamped _____
 2 PVC 4 ABS 6 Asbestos-Cement 9 Other (specify below) Welded _____
 Blank casing diameter: 10 in. to 25.5 in. Dia. 2" in. to 39.7 ft. Dia. _____ in. to _____ ft.
 Casing height above land surface: _____ in., weight _____ lbs./ft. Wall thickness or gauge No. 5440
 TYPE OF SCREEN OR PERFORATION MATERIAL:
 1 Steel 3 Stainless steel 5 Fiberglass 7 PVC 10 Asbestos-cement
 2 Brass 4 Galvanized steel 6 Concrete tile 8 RMP (SR) 11 Other (specify) _____
 12 None used (open hole)
 SCREEN OR PERFORATION OPENINGS ARE:
 1 Continuous slot 3 Mill slot 5 Gauzed wrapped 8 Saw cut 11 None (open hole)
 2 Louvered shutter 4 Key punched 6 Wire wrapped 9 Drilled holes
 7 Torch cut 10 Other (specify) _____
 SCREEN-PERFORATED INTERVALS: From 44.7 ft. to 39.7 ft., From _____ ft. to _____ ft.
 From _____ ft. to _____ ft., From _____ ft. to _____ ft.
 GRAVEL PACK INTERVALS: From 44.7 ft. to 37 ft., From _____ ft. to _____ ft.
 From _____ ft. to _____ ft., From _____ ft. to _____ ft.

6 GROUT MATERIAL: 1 Neat cement 2 Cement grout 3 Bentonite 4 Other Cement/Bentonite
 Grout Intervals: From 32 ft. to 8 ft. From 37 ft. to 32 ft., From _____ ft. to _____ ft.
 What is the nearest source of possible contamination:
 1 Septic tank 4 Lateral lines 7 Pit privy 10 Livestock pens 14 Abandoned water well
 2 Sewer lines 5 Cess pool 8 Sewage lagoon 11 Fuel storage 15 Oil well/Gas well
 3 Watertight sewer lines 6 Seepage pit 9 Feedyard 12 Fertilizer storage 16 Other (specify below)
 13 Insecticide storage GNB INC

Direction from well? _____ How many feet? _____

FROM	TO	LITHOLOGIC LOG	FROM	TO	PLUGGING INTERVALS
0	3	Gravel, Brick, Concrete			
3	15	Silty clay			
15	20	Silty clay			
20	25.5	Silty clay			
25.5	29	Fine sand, Silty sand			
29	31.5	Clay - medium			
31.5	44.7	Fine sand, Silty clay + sand			

7 CONTRACTOR'S OR LANDOWNER'S CERTIFICATION: This water well was (1) constructed, (2) reconstructed, or (3) plugged under my jurisdiction and was completed on (mo/day/year) 7-31-94 and this record is true to the best of my knowledge and belief. Kansas Water Well Contractor's License 81-735448-3. This Water Well Record was completed on (mo/day/yr) 8-25-94 under the business name of Burlington Environmental Inc. by (signature) Rust Schaffer