


LOCATION OF WATER WELL: County: Leavenworth Fraction: NE 1/4 SE 1/4 NW 1/4 Section Number: 1 Township Number: T 9 S Range Number: R 22 EW

Distance and direction from nearest town or city street address of well if located within city? 1825 South 4th Street, Leavenworth

WATER WELL OWNER: GNB, Inc. RR#, St. Address, Box #: 1825 South 4th Street City, State, ZIP Code: Leavenworth, Kans. 66048 Board of Agriculture, Division of Water Resources Application Number:

LOCATE WELL'S LOCATION WITH AN "X" IN SECTION BOX: DEPTH OF COMPLETED WELL: 43.5 ft. ELEVATION: 787

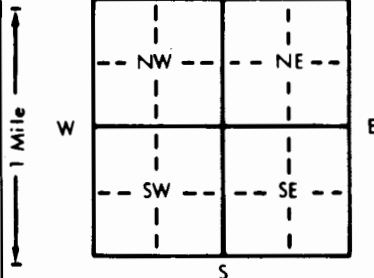

Depth(s) Groundwater Encountered: 18.09 ft. below land surface measured on mo/day/yr 3-27-95. Pump test data: Well water was ... Est. Yield ... Bore Hole Diameter: 7 in. to 43.5 in. WELL WATER TO BE USED AS: 5 Public water supply, 8 Air conditioning, 11 Injection well, 12 Other (Specify below). Was a chemical/bacteriological sample submitted to Department? Yes No; If yes, mo/day/yr sample was submitted.

TYPE OF BLANK CASING USED: 1 Steel, 2 PVC, 3 RMP (SR), 4 ABS, 5 Wrought iron, 6 Asbestos-Cement, 7 Fiberglass, 8 Concrete tile, 9 Other (specify below), 10 Monitoring well, 11 Injection well, 12 Other (Specify below). CASING JOINTS: Glued, Clamped, Welded, Threaded.

Blank casing diameter: 2 in. to 38.5 in. Dia: 10 in. to 27.5 in. Casing height above land surface: 0 in. weight: lbs./ft. Wall thickness or gauge No.

TYPE OF SCREEN OR PERFORATION MATERIAL: 1 Steel, 2 Brass, 3 Stainless steel, 4 Galvanized steel, 5 Fiberglass, 6 Concrete tile, 7 PVC, 8 RMP (SR), 9 ABS, 10 Asbestos-cement, 11 Other (specify), 12 None used (open hole).

SCREEN OR PERFORATION OPENINGS ARE: 1 Continuous slot, 2 Louvered shutter, 3 Mill slot, 4 Key punched, 5 Gauzed wrapped, 6 Wire wrapped, 7 Torch cut, 8 Saw cut, 9 Drilled holes, 10 Other (specify), 11 None (open hole).

SCREEN-PERFORATED INTERVALS: From 38.5 ft. to 43.5 ft. GRAVEL PACK INTERVALS: From 35.8 ft. to 43.5 ft.

GROUT MATERIAL: 1 Neat cement, 2 Cement grout, 3 Bentonite, 4 Other. Grout Intervals: From 0 ft. to 31.5 ft.

What is the nearest source of possible contamination: 1 Septic tank, 2 Sewer lines, 3 Watertight sewer lines, 4 Lateral lines, 5 Cess pool, 6 Seepage pit, 7 Pit privy, 8 Sewage lagoon, 9 Feedyard, 10 Livestock pens, 11 Fuel storage, 12 Fertilizer storage, 13 Insecticide storage, 14 Abandoned water well, 15 Oil well/Gas well, 16 Other (specify below).

Direction from well? FROM TO LITHOLOGIC LOG FROM TO PLUGGING INTERVALS

Table with columns for FROM, TO, LITHOLOGIC LOG, FROM, TO, PLUGGING INTERVALS. Handwritten entry: Removed Casings & plugged w/ cement/bentonite grout. 0-43.5'

CONTRACTOR'S OR LANDOWNER'S CERTIFICATION: This water well was (1) constructed, (2) reconstructed, or (3) plugged under my jurisdiction and was completed on (mo/day/year) Max. 30, 1995 and this record is true to the best of my knowledge and belief. Kansas Water Well Contractor's License No. 481 This Water Well Record was completed on (mo/day/yr) under the business name of Burlington Environmental by (signature) [Signature]