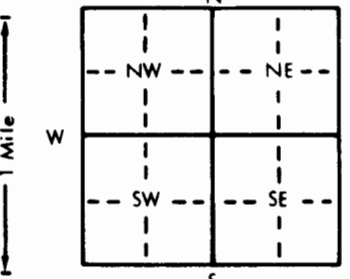


1 LOCATION OF WATER WELL: Fraction NE 1/4 SE 1/4 NW 1/4 Section Number 1 Township Number T 9 S Range Number R 22 EW
 County: Leavenworth

Distance and direction from nearest town or city street address of well if located within city?
1825 South 4th Street, Leavenworth

2 WATER WELL OWNER: GNB, Inc. Board of Agriculture, Division of Water Resources
 RR#, St. Address, Box #: 1825 South 4th Street Application Number:
 City, State, ZIP Code: Leavenworth, Kansas 66048

3 LOCATE WELL'S LOCATION WITH AN "X" IN SECTION BOX:  DEPTH OF COMPLETED WELL: 30 ft. ELEVATION: 785.40
 Depth(s) Groundwater Encountered 1. 1 ft. 2. 1 ft. 3. 1 ft.
 WELL'S STATIC WATER LEVEL 14.74 ft. below land surface measured on mo/day/yr 3-27-95
 Pump test data: Well water was 1 ft. after 1 hours pumping 1 gpm
 Est. Yield 1 gpm: Well water was 1 ft. after 1 hours pumping 1 gpm
 Bore Hole Diameter 7 in. to 30 ft., and 1 in. to 1 ft.
 WELL WATER TO BE USED AS:
 1 Domestic 3 Feedlot 6 Oil field water supply 9 Dewatering 12 Other (Specify below)
 2 Irrigation 4 Industrial 7 Lawn and garden only 10 Monitoring well
 Was a chemical/bacteriological sample submitted to Department? Yes NA No NA
 Water Well Disinfected? Yes NA No NA

5 TYPE OF BLANK CASING USED:
 1 Steel 3 RMP (SR) 5 Wrought iron 8 Concrete tile CASING JOINTS: Glued NA Clamped NA
 2 PVC 4 ABS 6 Asbestos-Cement 9 Other (specify below) Welded NA
 7 Fiberglass Threaded NA
 Blank casing diameter 2 in. to 19.6 ft., Dia 2 in. to 19.6 ft., Dia 2 in. to 19.6 ft.
 Casing height above land surface 0 in., weight 0 lbs./ft. Wall thickness or gauge No. 0
 TYPE OF SCREEN OR PERFORATION MATERIAL:
 1 Steel 3 Stainless steel 5 Fiberglass 8 RMP (SR) 10 Asbestos-cement
 2 Brass 4 Galvanized steel 6 Concrete tile 9 ABS 11 Other (specify) NA
 12 None used (open hole)
 SCREEN OR PERFORATION OPENINGS ARE:
 1 Continuous slot 3 Mill slot 5 Gauzed wrapped 8 Saw cut 11 None (open hole)
 2 Louvered shutter 4 Key punched 6 Wire wrapped 9 Drilled holes
 7 Torch cut 10 Other (specify) NA
 SCREEN-PERFORATED INTERVALS: From 19.6 ft. to 29.6 ft., From 19.6 ft. to 29.6 ft.
 GRAVEL PACK INTERVALS: From 16.5 ft. to 30 ft., From 16.5 ft. to 30 ft.

6 GROUT MATERIAL: 1 Neat cement 2 Cement grout 3 Bentonite 4 Other NA
 Grout Intervals: From 0 ft. to 16.5 ft., From 0 ft. to 16.5 ft.
 What is the nearest source of possible contamination:
 1 Septic tank 4 Lateral lines 7 Pit privy 10 Livestock pens 14 Abandoned water well
 2 Sewer lines 5 Cess pool 8 Sewage lagoon 11 Fuel storage 15 Oil well/Gas well
 3 Watertight sewer lines 6 Seepage pit 9 Feedyard 12 Fertilizer storage 16 Other (specify below) NA
 13 Insecticide storage NA
 Direction from well? NA How many feet? NA

FROM	TO	LITHOLOGIC LOG	FROM	TO	PLUGGING INTERVALS
					Plugged. Removed casing(s) & plugged w/ cement/bentonite grout 0'-30'.

7 CONTRACTOR'S OR LANDOWNER'S CERTIFICATION: This water well was (1) constructed, (2) reconstructed, or (3) plugged under my jurisdiction and was completed on (mo/day/year) Mar. 28, 1995 and this record is true to the best of my knowledge and belief. Kansas Water Well Contractor's License No. 481 This Water Well Record was completed on (mo/day/yr) 3-27-95 under the business name of Burley Environmental by (signature) [Signature]