


1 LOCATION OF WATER WELL: County: Leavenworth Co. Fraction: NW 1/4 SE 1/4 NW 1/4 Section Number: 1 Township Number: T 9 S Range Number: R 22 EW

Distance and direction from nearest town or city street address of well if located within city? 1825 South 4th Street

2 WATER WELL OWNER: GNB, INC RR#, St. Address, Box #: 1825 SO 4th ST City, State, ZIP Code: Leavenworth KS 66048 Board of Agriculture, Division of Water Resources Application Number:

3 LOCATE WELL'S LOCATION WITH AN "X" IN SECTION BOX:

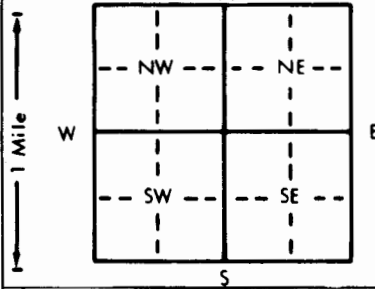

4 DEPTH OF COMPLETED WELL: 24 ft. ELEVATION: ± 79.3 Ft. Depth(s) Groundwater Encountered: 1. ft. 2. ft. 3. ft. WELL'S STATIC WATER LEVEL: 20.76 ft. below land surface measured on mo/day/yr 3-27-95

5 TYPE OF BLANK CASING USED: 2 PVC CASING JOINTS: Glued Clamped 1 Steel 3 RMP (SR) 6 Asbestos-Cement 9 Other (specify below) Welded 4 ABS 7 Fiberglass Threaded. Blank casing diameter: 2 in. to 16 ft., Dia. Casing height above land surface: 0 in., weight lbs./ft. Wall thickness or gauge No. TYPE OF SCREEN OR PERFORATION MATERIAL: 7 PVC 10 Asbestos-cement 11 Other (specify) 12 None used (open hole)

6 GROUT MATERIAL: 1 Neat cement 2 Cement grout 3 Bentonite 4 Other Grout Intervals: From 0 ft. to 12 ft. What is the nearest source of possible contamination: 1 Septic tank 4 Lateral lines 7 Pit privy 10 Livestock pens 14 Abandoned water well

Table with columns: FROM, TO, LITHOLOGIC LOG, FROM, TO, PLUGGING INTERVALS. Handwritten entry: Removed casing(s) & plugged w/ cement/bentonite grout. 0-26'

7 CONTRACTOR'S OR LANDOWNER'S CERTIFICATION: This water well was (1) constructed, (2) reconstructed, or (3) plugged under my jurisdiction and was completed on (mo/day/year) Mar. 30, 1995 and this record is true to the best of my knowledge and belief. Kansas Water Well Contractor's License No. 481 This Water Well Record was completed on (mo/day/yr) under the business name of Burlington Environmental by signature

INSTRUCTIONS: Use typewriter or ball point pen. PLEASE PRESS FIRMLY and PRINT clearly. Please fill in blanks, underline or circle the correct answers. Send top three copies to Kansas Department of Health and Environment, Bureau of Water, Topeka, Kansas 66620-0001. Telephone: 913-296-5545. Send one to WATER WELL OWNER and retain one for your records.