WATER WELL RECORD Form WWC-5 KSA 82a-1212

1 LOCATION OF WATER WELL: County: LEAVENWORTH | Fraction: SW ¼ NW ¼ SW ¼ | Section Number: 17 | Township Number: T 9 S | Range Number: R 23 E

Distance and direction from nearest town or city street address of well if located within city?
NOT APPLICABLE

2 WATER WELL OWNER: LEAVENWORTH WATERWORKS
RR#, St. Address, Box # : 601 DELAWARE
City, State, ZIP Code : LEAVENWORTH, KS 66048
Board of Agriculture, Division of Water Resources
Application Number:

3 LOCATE WELL'S LOCATION WITH AN "X" IN SECTION BOX:

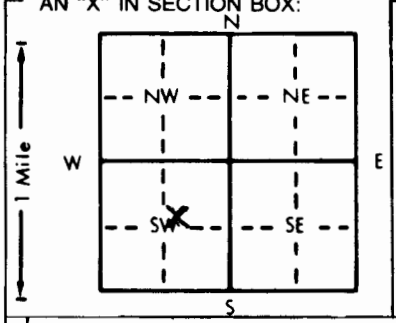

4 DEPTH OF COMPLETED WELL 73'-7" ft. ELEVATION: 758.2
Depth(s) Groundwater Encountered 1. 8'-8" ft. 2. ft. 3. ft.
WELL'S STATIC WATER LEVEL 8'8" ft. below land surface measured on mo/day/yr 10-13-92
Pump test data: Well water was 16'6" ft. after 4 hours pumping 1026 gpm
Est. Yield 700 gpm: Well water was ft. after hours pumping gpm
Bore Hole Diameter 56 in. to 73'-7" ft., and in. to ft.
WELL WATER TO BE USED AS: (5) Public water supply 8 Air conditioning 11 Injection well
1 Domestic 3 Feedlot 6 Oil field water supply 9 Dewatering 12 Other (Specify below)
2 Irrigation 4 Industrial 7 Lawn and garden only 10 Monitoring well
Was a chemical/bacteriological sample submitted to Department? Yes ..... No X ; If yes, mo/day/yr sample was submitted
Water Well Disinfected? (Yes) No

5 TYPE OF BLANK CASING USED: (1) Steel 3 RMP (SR) 5 Wrought iron 8 Concrete tile
2 PVC 4 ABS 6 Asbestos-Cement 9 Other (specify below)
7 Fiberglass
CASING JOINTS: Glued Clamped Welded X Threaded
Blank casing diameter 30 in. to 53'2" ft., Dia in. to ft., Dia in. to ft.
Casing height above land surface 216 in., weight 157.53 #/FT lbs./ft. Wall thickness or gauge No. 0.500 20
TYPE OF SCREEN OR PERFORATION MATERIAL:
1 Steel (3) Stainless steel 5 Fiberglass 7 PVC 8 RMP (SR) 10 Asbestos-cement
2 Brass 4 Galvanized steel 6 Concrete tile 9 ABS 11 Other (specify) 12 None used (open hole)
SCREEN OR PERFORATION OPENINGS ARE:
(1) Continuous slot 3 Mill slot 5 Gauzed wrapped 8 Saw cut 11 None (open hole)
2 Louvered shutter 4 Key punched 6 Wire wrapped 9 Drilled holes
7 Torch cut 10 Other (specify)
SCREEN-PERFORATED INTERVALS: From 53'-7" ft. to 73'-7" ft., From ft. to ft.
From ft. to ft., From ft. to ft.
GRAVEL PACK INTERVALS: From 20'0" ft. to 73'-7" ft., From ft. to ft.
From ft. to ft., From ft. to ft.

6 GROUT MATERIAL: 1 Neat cement (2) Cement grout (3) Bentonite 4 Other
Grout Intervals: From 0 ft. to 18 ft., From 18 ft. to 20 ft., From ft. to ft.
What is the nearest source of possible contamination: (2) (3)
1 Septic tank 4 Lateral lines 7 Pit privy 10 Livestock pens 14 Abandoned water well
2 Sewer lines 5 Cess pool 8 Sewage lagoon 11 Fuel storage 15 Oil well/Gas well
3 Watertight sewer lines 6 Seepage pit 9 Feedyard 12 Fertilizer storage 16 Other (specify below)
13 Insecticide storage WATER WELL
Direction from well? 3 NORTHWEST & SOUTHEAST How many feet? 350

FROM	TO	LITHOLOGIC LOG	FROM	TO	PLUGGING INTERVALS
		SEE ATTACHED LOG OF T.H. 2-92.			

7 CONTRACTOR'S OR LANDOWNER'S CERTIFICATION: This water well was (1) constructed, (2) reconstructed, or (3) plugged under my jurisdiction and was completed on (mo/day/year) 3-5-93 and this record is true to the best of my knowledge and belief. Kansas Water Well Contractor's License No. 102 This Water Well Record was completed on (mo/day/yr) 3-10-93
under the business name of LAINE-WESTERN CO. by (signature) Paul W. Laine

INSTRUCTIONS: Use typewriter or ball point pen. *PLEASE PRESS FIRMLY* and *PRINT* clearly. Please fill in blanks, underline or circle the correct answers. Send top three copies to Kansas Department of Health and Environment, Bureau of Water, Topeka, Kansas 66620-0001. Telephone: 913-296-5545. Send one to WATER WELL OWNER and retain one for your records.

OFFICE USE ONLY T R E/W SEC. ¼ ¼ ¼