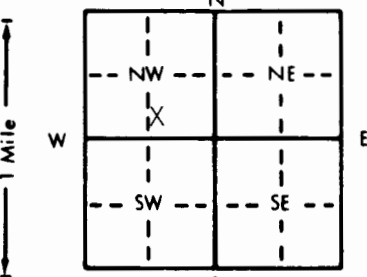


1 LOCATION OF WATER WELL: County: Leavenworth	Fraction SW ¼ SE ¼ NW ¼	Section Number 19	Township Number T 9 S	Range Number R 23 <b>EW</b>
--	----------------------------	----------------------	--------------------------	--------------------------------

Distance and direction from nearest town or city street address of well if located within city?  
Lansing Correctional Facility - Area #3

2 WATER WELL OWNER:  
 RR#, St. Address, Box # : State of Kansas Board of Agriculture, Division of Water Resources  
 City, State, ZIP Code : Application Number:

3 LOCATE WELL'S LOCATION WITH AN "X" IN SECTION BOX: 	4 DEPTH OF COMPLETED WELL: 52 ft. ELEVATION: 825.122 Depth(s) Groundwater Encountered 1. ft. 2. ft. 3. ft. WELL'S STATIC WATER LEVEL 44.83 ft. below land surface measured on mo/day/yr 5-13-93 Pump test data: Well water was . ft. after . hours pumping . gpm Est. Yield . gpm: Well water was . ft. after . hours pumping . gpm Bore Hole Diameter . in. to . ft., and . in. to . ft. WELL WATER TO BE USED AS: 1 Domestic 3 Feedlot 5 Public water supply 8 Air conditioning 11 Injection well 2 Irrigation 4 Industrial 6 Oil field water supply 9 Dewatering 12 Other (Specify below) 7 Lawn and garden only <b>10 Monitoring well</b> Was a chemical/bacteriological sample submitted to Department? Yes . No <b>X</b> ; If yes, mo/day/yr sample was submitted Water Well Disinfected? Yes . No <b>X</b>
--	--

5 TYPE OF BLANK CASING USED:  
 1 Steel 3 RMP (SR) 5 Wrought iron 8 Concrete tile CASING JOINTS: Glued . Clamped .  
**2 PVC** 4 ABS 6 Asbestos-Cement 9 Other (specify below) **Welded**  
 7 Fiberglass **Threaded**  
 Blank casing diameter . in. to . ft., Dia . in. to . ft., Dia . in. to . ft.  
 Casing height above land surface 1.85 ft. in., weight . lbs./ft. Wall thickness or gauge No. .  
 TYPE OF SCREEN OR PERFORATION MATERIAL:  
 1 Steel 3 Stainless steel 5 Fiberglass 7 PVC 10 Asbestos-cement  
 2 Brass 4 Galvanized steel 6 Concrete tile 8 RMP (SR) 11 Other (specify) .  
 9 ABS 12 None used (open hole)  
 SCREEN OR PERFORATION OPENINGS ARE:  
**1 Continuous slot** 3 Mill slot 5 Gauzed wrapped 8 Saw cut 11 None (open hole)  
 2 Louvered shutter 4 Key punched 6 Wire wrapped 9 Drilled holes  
 7 Torch cut 10 Other (specify) .  
 SCREEN-PERFORATED INTERVALS: From 42 ft. to 52 ft., From . ft. to . ft.  
 GRAVEL PACK INTERVALS: From 41 ft. to 52 ft., From . ft. to . ft.

6 GROUT MATERIAL: 1 Neat cement 2 Cement grout **3 Bentonite** 4 Other  
 Grout Intervals: From **X 0** ft. to 41 ft., From . ft. to . ft., From . ft. to . ft.  
 What is the nearest source of possible contamination:  
 1 Septic tank 4 Lateral lines 7 Pit privy 10 Livestock pens 14 Abandoned water well  
 2 Sewer lines 5 Cess pool 8 Sewage lagoon 11 Fuel storage 15 Oil well/Gas well  
 3 Watertight sewer lines 6 Seepage pit 9 Feedyard 12 Fertilizer storage **16 Other (specify below)**  
 Drum Storage  
 Direction from well? How many feet?

FROM	TO	LITHOLOGIC LOG	FROM	TO	PLUGGING INTERVALS
0	2	Yellowish-Orange Very Fine Sandy Clay			
2	51	Red Shale (fill material?)			
51	51.8	Black Clay with Silts and Red Shale			
51.8	52	Silty Fine Sands			

7 CONTRACTOR'S OR LANDOWNER'S CERTIFICATION: This water well was **(1) constructed**, (2) reconstructed, or (3) plugged under my jurisdiction and was completed on (mo/day/year) 5-13-93 and this record is true to the best of my knowledge and belief. Kansas Water Well Contractor's License No. 563 This Water Well Record was completed on (mo/day/yr) 5-24-93 under the business name of Envirocorp Services & Technology, Inc. by (signature) *Christy J. Masterson*