

M.W. # 6A

WATER WELL RECORD Form WWC-5 KSA 82a-1212


1 LOCATION OF WATER WELL: County: <u>Leavenworth</u>	Fraction <u>SW 1/4 NE 1/4 SW 1/4</u>	Section Number <u>30</u>	Township Number <u>T 9 S</u>	Range Number <u>R 23 E</u>
---	---	-----------------------------	---------------------------------	-------------------------------

Distance and direction from nearest town or city street address of well if located within city?

1/2 mile South of Lansing, Kansas

2 WATER WELL OWNER: RR#, St. Address, Box # : City, State, ZIP Code	<u>City of Leavenworth</u> <u>100 N 5th St</u> <u>Leavenworth, KS 66048</u>	Board of Agriculture, Division of Water Resources Application Number:
---	---	--

3 LOCATE WELL'S LOCATION WITH AN "X" IN SECTION BOX:

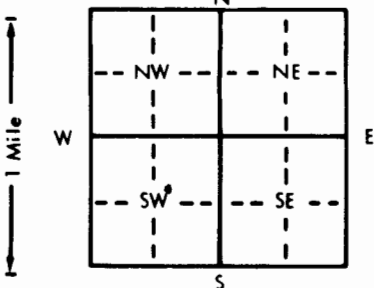

4 DEPTH OF COMPLETED WELL: <u>17.2</u> ft. ELEVATION: <u>758.84</u>
Depth(s) Groundwater Encountered 1. <u>est. 10</u> ft. 2. ft. 3. ft.
WELL'S STATIC WATER LEVEL: <u>10.4</u> ft. below land surface measured on mo/day/yr <u>8/10/93</u>
Pump test data: Well water was ft. after hours pumping gpm
Est. Yield gpm: Well water was ft. after hours pumping gpm
Bore Hole Diameter: <u>8</u> in. to <u>17.2</u> ft., and in. to ft.
WELL WATER TO BE USED AS:
5 Public water supply 8 Air conditioning 11 Injection well
1 Domestic 3 Feedlot 6 Oil field water supply 9 Dewatering 12 Other (Specify below)
2 Irrigation 4 Industrial 7 Lawn and garden only <u>10 Monitoring well</u>
Was a chemical/bacteriological sample submitted to Department? Yes No ; If yes, mo/day/yr sample was submitted
Water Well Disinfected? Yes No

5 TYPE OF BLANK CASING USED:	5 Wrought iron	8 Concrete tile	CASING JOINTS: Glued Clamped
1 Steel	3 RMP (SR)	6 Asbestos-Cement	9 Other (specify below)
<u>2 PVC</u>	4 ABS	7 Fiberglass	Welded
Blank casing diameter: <u>2</u> in. to <u>12.2</u> ft., Dia			Threaded. <input checked="" type="checkbox"/>
Casing height above land surface: in., weight lbs./ft.			Wall thickness or gauge No. <u>Sch 40</u>

TYPE OF SCREEN OR PERFORATION MATERIAL:	7 PVC	10 Asbestos-cement
1 Steel	3 Stainless steel	5 Fiberglass
2 Brass	4 Galvanized steel	6 Concrete tile
8 RMP (SR)	11 Other (specify)	12 None used (open hole)

SCREEN OR PERFORATION OPENINGS ARE:	5 Gauzed wrapped	8 Saw cut	11 None (open hole)
1 Continuous slot	6 Wire wrapped	9 Drilled holes	
2 Louvered shutter	7 Torch cut	10 Other (specify)	

SCREEN-PERFORATED INTERVALS:	From <u>12.2</u> ft. to <u>17.2</u> ft., From ft. to ft.
GRAVEL PACK INTERVALS:	From <u>10.0</u> ft. to <u>17.2</u> ft., From ft. to ft.

6 GROUT MATERIAL:	1 Neat cement	<u>2 Cement grout</u>	<u>3 Bentonite</u>	4 Other
Grout Intervals: From <u>0.0</u> ft. to <u>8.0</u> ft., From <u>8.0</u> ft. to <u>10.0</u> ft., From ft. to ft.				

What is the nearest source of possible contamination:	10 Livestock pens	14 Abandoned water well
1 Septic tank	4 Lateral lines	7 Pit privy
2 Sewer lines	5 Cess pool	8 Sewage lagoon
3 Watertight sewer lines	6 Seepage pit	9 Feedyard
		11 Fuel storage
		12 Fertilizer storage
		13 Insecticide storage
		15 Oil well/Gas well
		16 Other (specify below)
		<u>Landfill - On-site</u>

Direction from well?		LITHOLOGIC LOG		PLUGGING INTERVALS	
FROM	TO	FROM	TO	FROM	TO
0.0	16.0				
		Silt, light brown wet below about 10 feet.			
16.0	17.2				
		Shale, gray, firm, silty			
	17.2				
		T.D.			

7 CONTRACTOR'S OR LANDOWNER'S CERTIFICATION: This water well was <u>(1) constructed</u> , <u>(2) reconstructed</u> , or <u>(3) plugged</u> (under my jurisdiction and was completed on (mo/day/year) <u>8/10/93</u> and this record is true to the best of my knowledge and belief. Kansas Water Well Contractor's License No. This Water Well Record was completed on (mo/day/yr) <u>8/11/93</u> under the business name of <u>KDHE</u> by (signature) <u>Manu W Hoff</u>
--