


MW #5

1 LOCATION OF WATER WELL: Fraction SE 1/4 NW 1/4 SW 1/4 Section Number 30 Township Number T 9 S Range Number R 23 E
 County: Leavenworth
 Distance and direction from nearest town or city street address of well if located within city?

2 WATER WELL OWNER: City of Leavenworth
 RR#, St. Address, Box #: 100 N 5th St
 City, State, ZIP Code: Leavenworth, KS 66048
 Board of Agriculture, Division of Water Resources
 Application Number: 786.29

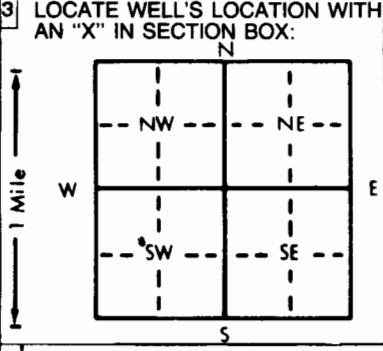

4 DEPTH OF COMPLETED WELL: 13.2 ft. ELEVATION: 786.29
 Depth(s) Groundwater Encountered 1. 5.7 ft. 2. _____ ft. 3. _____ ft.
 WELL'S STATIC WATER LEVEL _____ ft. below land surface measured on mo/day/yr _____
 Pump test data: Well water was _____ ft. after _____ hours pumping _____ gpm
 Est. Yield _____ gpm: Well water was _____ ft. after _____ hours pumping _____ gpm
 Bore Hole Diameter: 8 in. to 13.3 ft., and _____ in. to _____ ft.
 WELL WATER TO BE USED AS:
 5 Public water supply 8 Air conditioning 11 Injection well
 1 Domestic 3 Feedlot 6 Oil field water supply 9 Dewatering 12 Other (Specify below)
 2 Irrigation 4 Industrial 7 Lawn and garden only 10 Monitoring well
 Was a chemical/bacteriological sample submitted to Department? Yes _____ No _____; If yes, mo/day/yr sample was submitted _____
 Water Well Disinfected? Yes _____ No _____

5 TYPE OF BLANK CASING USED:
 1 Steel 3 RMP (SR) 5 Wrought iron 8 Concrete tile CASING JOINTS: Glued _____ Clamped _____
2 PVC 4 ABS 6 Asbestos-Cement 9 Other (specify below) Welded _____
 7 Fiberglass Threaded _____
 Blank casing diameter 2 in. to 8.3 ft., Dia _____ in. to _____ ft., Dia _____ in. to _____ ft.
 Casing height above land surface _____ in., weight _____ lbs./ft. Wall thickness or gauge No. Sch 40
 TYPE OF SCREEN OR PERFORATION MATERIAL:
 1 Steel 3 Stainless steel 5 Fiberglass 7 PVC 10 Asbestos-cement
 2 Brass 4 Galvanized steel 6 Concrete tile 9 ABS 11 Other (specify) _____
 12 None used (open hole)
 SCREEN OR PERFORATION OPENINGS ARE:
 1 Continuous slot 3 Mill slot 5 Gauzed wrapped 8 Saw cut 11 None (open hole)
 2 Louvered shutter 4 Key punched 6 Wire wrapped 9 Drilled holes
 7 Torch cut 10 Other (specify) _____
 SCREEN-PERFORATED INTERVALS: From 8.3 ft. to 13.3 ft., From _____ ft. to _____ ft.
 From _____ ft. to _____ ft., From _____ ft. to _____ ft.
 GRAVEL PACK INTERVALS: From 2.3 ft. to 13.3 ft., From _____ ft. to _____ ft.
 From _____ ft. to _____ ft., From _____ ft. to _____ ft.

6 GROUT MATERIAL: 1 Neat cement 2 Cement grout 3 Bentonite 4 Other _____
 Grout Intervals: From 2.0 ft. to 6.3 ft., From 0 ft. to 2.0 ft., From _____ ft. to _____ ft.
 What is the nearest source of possible contamination:
 1 Septic tank 4 Lateral lines 7 Pit privy 10 Livestock pens 14 Abandoned water well
 2 Sewer lines 5 Cess pool 8 Sewage lagoon 11 Fuel storage 15 Oil well/Gas well
 3 Watertight sewer lines 6 Seepage pit 9 Feedyard 12 Fertilizer storage 16 Other (specify below)
Landfill - on-site
 Direction from well? _____ How many feet? _____

| FROM | TO | LITHOLOGIC LOG | FROM | TO | PLUGGING INTERVALS |
|------|------|-----------------------------|------|----|--------------------|
| 0.0 | 9.5 | Soft brown, slightly clayey | | | |
| 9.5 | 10.0 | Limestone and sandy silt | | | |
| 10.0 | 13.3 | Shale brown to gray green | | | |
| | 13.3 | T.D. | | | |

7 CONTRACTOR'S OR LANDOWNER'S CERTIFICATION: This water well was (1) constructed, (2) reconstructed, or (3) plugged under my jurisdiction and was completed on (mo/day/year) 6/13/73 and this record is true to the best of my knowledge and belief. Kansas Water Well Contractor's License No. _____ This Water Well Record was completed on (mo/day/yr) 8/11/73 under the business name of KDHE by (signature) Murray W. Jett