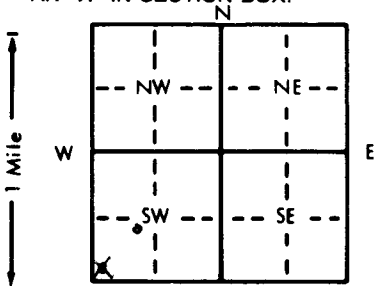


1 LOCATION OF WATER WELL: Fraction NE 1/4 SW 1/4 SW 1/4 Section Number 30 Township Number T 9 S Range Number R 23 E
 County: Leavenworth
 Distance and direction from nearest town or city street address of well if located within city?

1/2 mile south of Lansing, Kansas

2 WATER WELL OWNER: City of Leavenworth
 RR#, St. Address, Box #: 100 N 5th Street
 City, State, ZIP Code: Leavenworth, KS 66048
 Board of Agriculture, Division of Water Resources
 Application Number:

3 LOCATE WELL'S LOCATION WITH AN "X" IN SECTION BOX:

 4 DEPTH OF COMPLETED WELL: 17.1 ft. ELEVATION:
 Depth(s) Groundwater Encountered 1. 10.0 ft. 2. 10.0 ft. 3. 10.0 ft.
 WELL'S STATIC WATER LEVEL 10.0 ft. below land surface measured on mo/day/yr 6/29/93
 Bore Hole Diameter: 8 in. to 17.1 ft., and 17.1 in. to 17.1 ft.
 WELL WATER TO BE USED AS:
 1 Domestic 2 Irrigation 3 Feedlot 4 Industrial 5 Public water supply 6 Oil field water supply 7 Lawn and garden only 8 Air conditioning 9 Dewatering 10 Monitoring well 11 Injection well 12 Other (Specify below)
 Was a chemical/bacteriological sample submitted to Department? Yes No; If yes, mo/day/yr sample was submitted
 Water Well Disinfected? Yes No

5 TYPE OF BLANK CASING USED:
 1 Steel 2 PVC 3 RMP (SR) 4 ABS 5 Wrought iron 6 Asbestos-Cement 7 Fiberglass 8 Concrete tile 9 Other (specify below)
 CASING JOINTS: Glued Clamped Welded Threaded
 Casing height above land surface 30 in., weight 40 lbs./ft. Wall thickness or gauge No. 40
 TYPE OF SCREEN OR PERFORATION MATERIAL:
 1 Steel 2 Brass 3 Stainless steel 4 Galvanized steel 5 Fiberglass 6 Concrete tile 7 PVC 8 RMP (SR) 9 ABS 10 Asbestos-cement 11 Other (specify) 12 None used (open hole)
 SCREEN OR PERFORATION OPENINGS ARE:
 1 Continuous slot 2 Louvered shutter 3 Mill slot 4 Key punched 5 Gauzed wrapped 6 Wire wrapped 7 Torch cut 8 Saw cut 9 Drilled holes 10 Other (specify) 11 None (open hole)

6 GROUT MATERIAL: 1 Neat cement 2 Cement grout 3 Bentonite 4 Other
 Grout Intervals: From 0 ft. to 13.1 ft., From 2 ft. to 3 ft., From 2 ft. to 3 ft.
 What is the nearest source of possible contamination:
 1 Septic tank 2 Sewer lines 3 Watertight sewer lines 4 Lateral lines 5 Cess pool 6 Seepage pit 7 Pit privy 8 Sewage lagoon 9 Feedyard 10 Livestock pens 11 Fuel storage 12 Fertilizer storage 13 Insecticide storage 14 Abandoned water well 15 Oil well/Gas well 16 Other (specify below) Landfill - on site

Direction from well?		LITHOLOGIC LOG		PLUGGING INTERVALS	
FROM	TO	FROM	TO	FROM	TO
0.0	12.0				
		Silty clay, med. brown			
12.0	12.5	Limestone			
12.5	13.0	shaly breccia			
13.0	17.1	limestone, hard, gray			
17.1		T.D.			

7 CONTRACTOR'S OR LANDOWNER'S CERTIFICATION: This water well was (1) constructed (2) reconstructed, or (3) plugged under my jurisdiction and was completed on (mo/day/year) 6/30/93 and this record is true to the best of my knowledge and belief. Kansas Water Well Contractor's License No. 811193 This Water Well Record was completed on (mo/day/yr) 8/11/93 under the business name of KDITE by (signature) Man W. Heffel