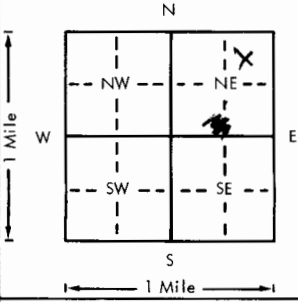


USE TYPEWRITER OR BALL POINT PEN-PRESS FIRMLY, PRINT CLEARLY.

*done*

WATER WELL RECORD  
KSA 82a-1201-1215

Kansas Department of Health and Environment-Division of Environment  
(Water well Contractors)  
Topeka, Kansas 66620

1. Location of well:	County <b>Leavenworth</b>	Fraction <b>SE 1/4 SW 1/4 NE 1/4</b>	Section number <b>33</b>	Township number T <b>9</b> S R	Range number <b>23</b> EW
2. Distance and direction from nearest town or city: Street address of well location if in city: <b>1 mile east of Lansing, Kansas</b>			3. Owner of well: <b>Mr. Richard Lee</b> R.R. or street: <b>R. R. 3 Box 74A</b> City, state, zip code: <b>Leavenworth, Kansas</b>		
4. Locate with "X" in section below: Sketch map: 			6. Bore hole dia. <b>8</b> in. Completion date <b>6-22-78</b> Well depth <b>60</b> ft.		
5. Type and color of material			7. <input checked="" type="checkbox"/> Cable tool <input checked="" type="checkbox"/> Rotary <input type="checkbox"/> Driven <input type="checkbox"/> Dug <input type="checkbox"/> Hollow rod <input type="checkbox"/> Jetted <input type="checkbox"/> Bored <input type="checkbox"/> Reverse rotary		
			8. Use: <input checked="" type="checkbox"/> Domestic <input type="checkbox"/> Public supply <input type="checkbox"/> Industry <input type="checkbox"/> Irrigation <input type="checkbox"/> Air conditioning <input type="checkbox"/> Stock <input type="checkbox"/> Lawn <input type="checkbox"/> Oil field water <input type="checkbox"/> Other		
			9. Casing: Material <b>PL</b> Height: <b>Above or below</b> Threaded <input type="checkbox"/> Welded <input checked="" type="checkbox"/> Surface <b>18</b> in. RMP <input type="checkbox"/> PVC <input checked="" type="checkbox"/> Weight <input type="checkbox"/> lbs./ft. Dia. <b>5</b> in. to <b>60</b> ft. depth Wall Thickness: inches or Dia. <input type="checkbox"/> in. to <input type="checkbox"/> ft. depth Gauge No. <b>.265</b>		
			10. Screen: Manufacturer's name <b>(Slotted Pipe) Vinylplex, Inc.</b> Type <b>PVC</b> Dia. <b>5"</b> Slot/gauze <b>1.06 1/16</b> Length <b>25'</b> Set between <b>15</b> ft. and <b>40</b> ft. ft. and <input type="checkbox"/> ft. Gravel pack? <input checked="" type="checkbox"/> Size range of material <b>1/4 - 1/8</b>		
			11. Static water level: <b>10</b> ft. below land surface Date <b>6-22-78</b> mo./day/yr.		
12. Pumping level below land surfaces: ft. after _____ hrs. pumping _____ g.p.m. ft. after _____ hrs. pumping _____ g.p.m. Estimated maximum yield <b>15</b> g.p.m.					
13. Water sample submitted: _____ mo./day/yr. Yes <input checked="" type="checkbox"/> No <input type="checkbox"/> Date _____					
14. Well head completion: <b>18</b> <input checked="" type="checkbox"/> Pitless adapter _____ Inches above grade					
15. Well grouted? <b>Yes</b> With: <input checked="" type="checkbox"/> Neat cement <input type="checkbox"/> Bentonite <input type="checkbox"/> Concrete Depth: From <b>3</b> ft. to <b>15</b> ft.					
16. Nearest source of possible contamination: ft. <b>100'</b> Direction <b>east</b> Type <b>creek</b> Well disinfected upon completion? <input checked="" type="checkbox"/> Yes <input type="checkbox"/> No					
17. Pump: <input checked="" type="checkbox"/> Not installed Manufacturer's name _____ Model number _____ HP _____ Volts _____ Length of drop pipe _____ ft. capacity _____ g.p.m. Type: <input type="checkbox"/> Submersible <input type="checkbox"/> Turbine <input type="checkbox"/> Jet <input type="checkbox"/> Reciprocating <input type="checkbox"/> Centrifugal <input type="checkbox"/> Other					
(Use a second sheet if needed)					
18. Elevation: <b>770</b>	19. Remarks:	20. Water well contractor's certification: This well was drilled under my jurisdiction and this report is true to the best of my knowledge and belief. <b>BREUER, INC.</b> <b>174</b> Business name License No. Address <b>Box 147, Basehor, Ks.</b> Signed <i>[Signature]</i> Date <b>6-23-78</b> Authorized representative			

T  
R  
S  
1/4  
1/4  
1/4  
1/4