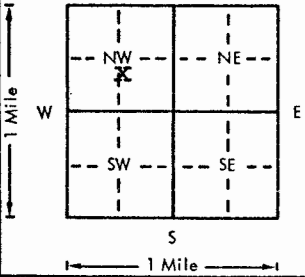


USE TYPEWRITER OR BALL POINT PEN-PRESS FIRMLY, PRINT CLEARLY.

WATER WELL RECORD
KSA 82a-1201-1215

Kansas Department of Health and Environment-Division of Environment
(Water well Contractors)
Topeka, Kansas 66620

1. Location of well:		County Leavenworth	Fraction SW SE NW 1/4 1/4 1/4	Section number 33	Township number 9	Range number E/W		
2. Distance and direction from nearest town or city: Street address of well location if in city: 1/2 mile east of Lansing city limits			3. Owner of well: Mr. Paul Serwon R.R. or street: 12373 Merion Drive City, state, zip code: Kansas City, Kansas					
4. Locate with "X" in section below: N W E S 1 Mile			Sketch map: 		6. Bore hole dia. 6 in. Completion date 3-18-76 Well depth 100 ft.			
5. Type and color of material			From		To			
			TEST NO. 2					
			Top Soil		0	3		
			Brown Clay		3	20		
			Coarse Sand - Medium Gravel (1/2 gpm)		20	21		
			Grey Shale		21	88		
			Brown Linc		88	100		
18. Elevation: Topography: <input type="checkbox"/> Hill <input type="checkbox"/> Slope <input type="checkbox"/> Upland <input type="checkbox"/> Valley			19. Remarks: Well filled to top with cuttings & 2 sacks of cement.			20. Water well contractor's certification: This well was drilled under my jurisdiction and this report is true to the best of my knowledge and belief. BREUER, INC. License No. 174 Address Box 147 Basehor, Ks. Signed _____ Date _____ Authorized representative		

T
R
W
E
S
E
N
W
1/4
1/4
1/4
1/4