

MW5

1 LOCATION OF WATER WELL:		Fraction	Section Number	Township Number	Range Number
County: Leavenworth		SW ¼ NW ¼ NW ¼ NW ¼	30	T 9 S	23 X E W

Street/Rural Address of Well Location; if unknown, distance & direction from nearest town or intersection: If at owner's address, check here <input type="checkbox"/>		Global Positioning Systems (GPS) information:
601 S Main, Lansing, KS		Latitude: NA (in decimal degrees)
		Longitude: NA (in decimal degrees)
		Elevation: NA
		Horizontal Datum <input type="checkbox"/> WGS84, <input type="checkbox"/> NAD83, <input type="checkbox"/> NAD27
		Collection Method:
		<input type="checkbox"/> GPS unit (Make/model: _____)
		<input type="checkbox"/> Digital Map/Photo, <input type="checkbox"/> Topographic Map <input type="checkbox"/> Land Survey
		Est. Accuracy: <input type="checkbox"/> <3 m, <input type="checkbox"/> 3-5 m, <input type="checkbox"/> 5-15 m, <input type="checkbox"/> >15 m

2 WATER WELL OWNER: RR#, St. Address, Box #: KDHE (Seven Eleven #904) City, State ZIP Code: 1000 SW Jackson Blvd Topeka, KS 66612	
--	--

3 MARK WELL'S LOCATION WITH AN "X" IN SECTION BOX: 	4 DEPTH OF WELL 11.66 ft. MW5 WELL'S STATIC WATER LEVEL NA ft WELL WAS USED AS: <table style="width:100%;"> <tr> <td><input type="checkbox"/> Domestic</td> <td><input type="checkbox"/> Public Water Supply</td> <td><input type="checkbox"/> Dewatering</td> </tr> <tr> <td><input type="checkbox"/> Irrigation</td> <td><input type="checkbox"/> Oil Field Water Supply</td> <td><input checked="" type="checkbox"/> Monitoring</td> </tr> <tr> <td><input type="checkbox"/> Feedlot</td> <td><input type="checkbox"/> Domestic (Lawn & Garden)</td> <td><input type="checkbox"/> Injection Well</td> </tr> <tr> <td><input type="checkbox"/> Industrial</td> <td><input type="checkbox"/> Air Conditioning</td> <td><input type="checkbox"/> Other _____</td> </tr> </table> <p>Was a chemical/bacteriological sample submitted to Department? Yes <input type="checkbox"/> No <input checked="" type="checkbox"/></p>	<input type="checkbox"/> Domestic	<input type="checkbox"/> Public Water Supply	<input type="checkbox"/> Dewatering	<input type="checkbox"/> Irrigation	<input type="checkbox"/> Oil Field Water Supply	<input checked="" type="checkbox"/> Monitoring	<input type="checkbox"/> Feedlot	<input type="checkbox"/> Domestic (Lawn & Garden)	<input type="checkbox"/> Injection Well	<input type="checkbox"/> Industrial	<input type="checkbox"/> Air Conditioning	<input type="checkbox"/> Other _____
<input type="checkbox"/> Domestic	<input type="checkbox"/> Public Water Supply	<input type="checkbox"/> Dewatering											
<input type="checkbox"/> Irrigation	<input type="checkbox"/> Oil Field Water Supply	<input checked="" type="checkbox"/> Monitoring											
<input type="checkbox"/> Feedlot	<input type="checkbox"/> Domestic (Lawn & Garden)	<input type="checkbox"/> Injection Well											
<input type="checkbox"/> Industrial	<input type="checkbox"/> Air Conditioning	<input type="checkbox"/> Other _____											

5 TYPE OF BLANK CASING USED:	
<input type="checkbox"/> Steel <input checked="" type="checkbox"/> PVC	<input type="checkbox"/> RMP (SR) <input type="checkbox"/> ABS
<input type="checkbox"/> Wrought <input type="checkbox"/> Asbestos-Cement	<input type="checkbox"/> Fiberglass <input type="checkbox"/> Concrete Tile
<input type="checkbox"/> Other (Specific below) _____	
Blank casing diameter 2 in.	Was casing pulled? Yes <input type="checkbox"/> No <input checked="" type="checkbox"/> If yes, how much _____
Casing height above or below land surface NA in.	

6 GROUT PLUG MATERIAL:	
<input type="checkbox"/> Neat cement	<input type="checkbox"/> Cement grout <input checked="" type="checkbox"/> Bentonite <input type="checkbox"/> Other _____
Grout Plug Intervals: From 0 ft to 11.66 ft, From _____ ft to _____ ft, From _____ ft to _____ ft,	
What is the nearest source of possible contamination:	
<input type="checkbox"/> Septic tank <input type="checkbox"/> Sewer lines <input type="checkbox"/> Watertight sewer lines <input type="checkbox"/> Lateral lines <input type="checkbox"/> Cess pool	<input type="checkbox"/> Seepage pit <input type="checkbox"/> Pit privy <input type="checkbox"/> Sewage lagoon <input type="checkbox"/> Feed yard <input type="checkbox"/> Livestock pens
<input type="checkbox"/> Fuel storage <input type="checkbox"/> Fertilizer storage <input type="checkbox"/> Insecticide storage <input type="checkbox"/> Abandoned water well <input type="checkbox"/> Oil well/Gas well	<input type="checkbox"/> Other (specify below) _____ Direction from well? _____ How many feet? _____

FROM	TO	PLUGGING MATERIALS
0	11.66	Bentonite

FROM	TO	PLUGGING MATERIALS

KDHE ID: Seven Eleven #904; U4-052-10861	
--	--

7 CONTRACTOR'S OR LANDOWNER'S CERTIFICATION:	
This water well was plugged under my jurisdiction and was completed on (mo/day/year) 3/9/2020 and this record is true to the best of my knowledge and belief. Kansas Water Contractor's License No. 757 . This Water Well Record was completed on (mo/day/year) 3/10/2020 under the business name of Larsen & Associates, Inc. By (signature) _____	

Send one white copy to Kansas Department of Health & Environment, Geology Section, 1000 SW Jackson Street, Ste. 420, Topeka, KS 66612-1367. Send one copy to WATER WELL OWNER and retain one for your records
Visit us at <http://www.kdheks.gov/waterwell/index.html> Telephone 785-296-5524.

KSA82a-1212 Revised 1/20/2015

Leavenworth

30-9-23E

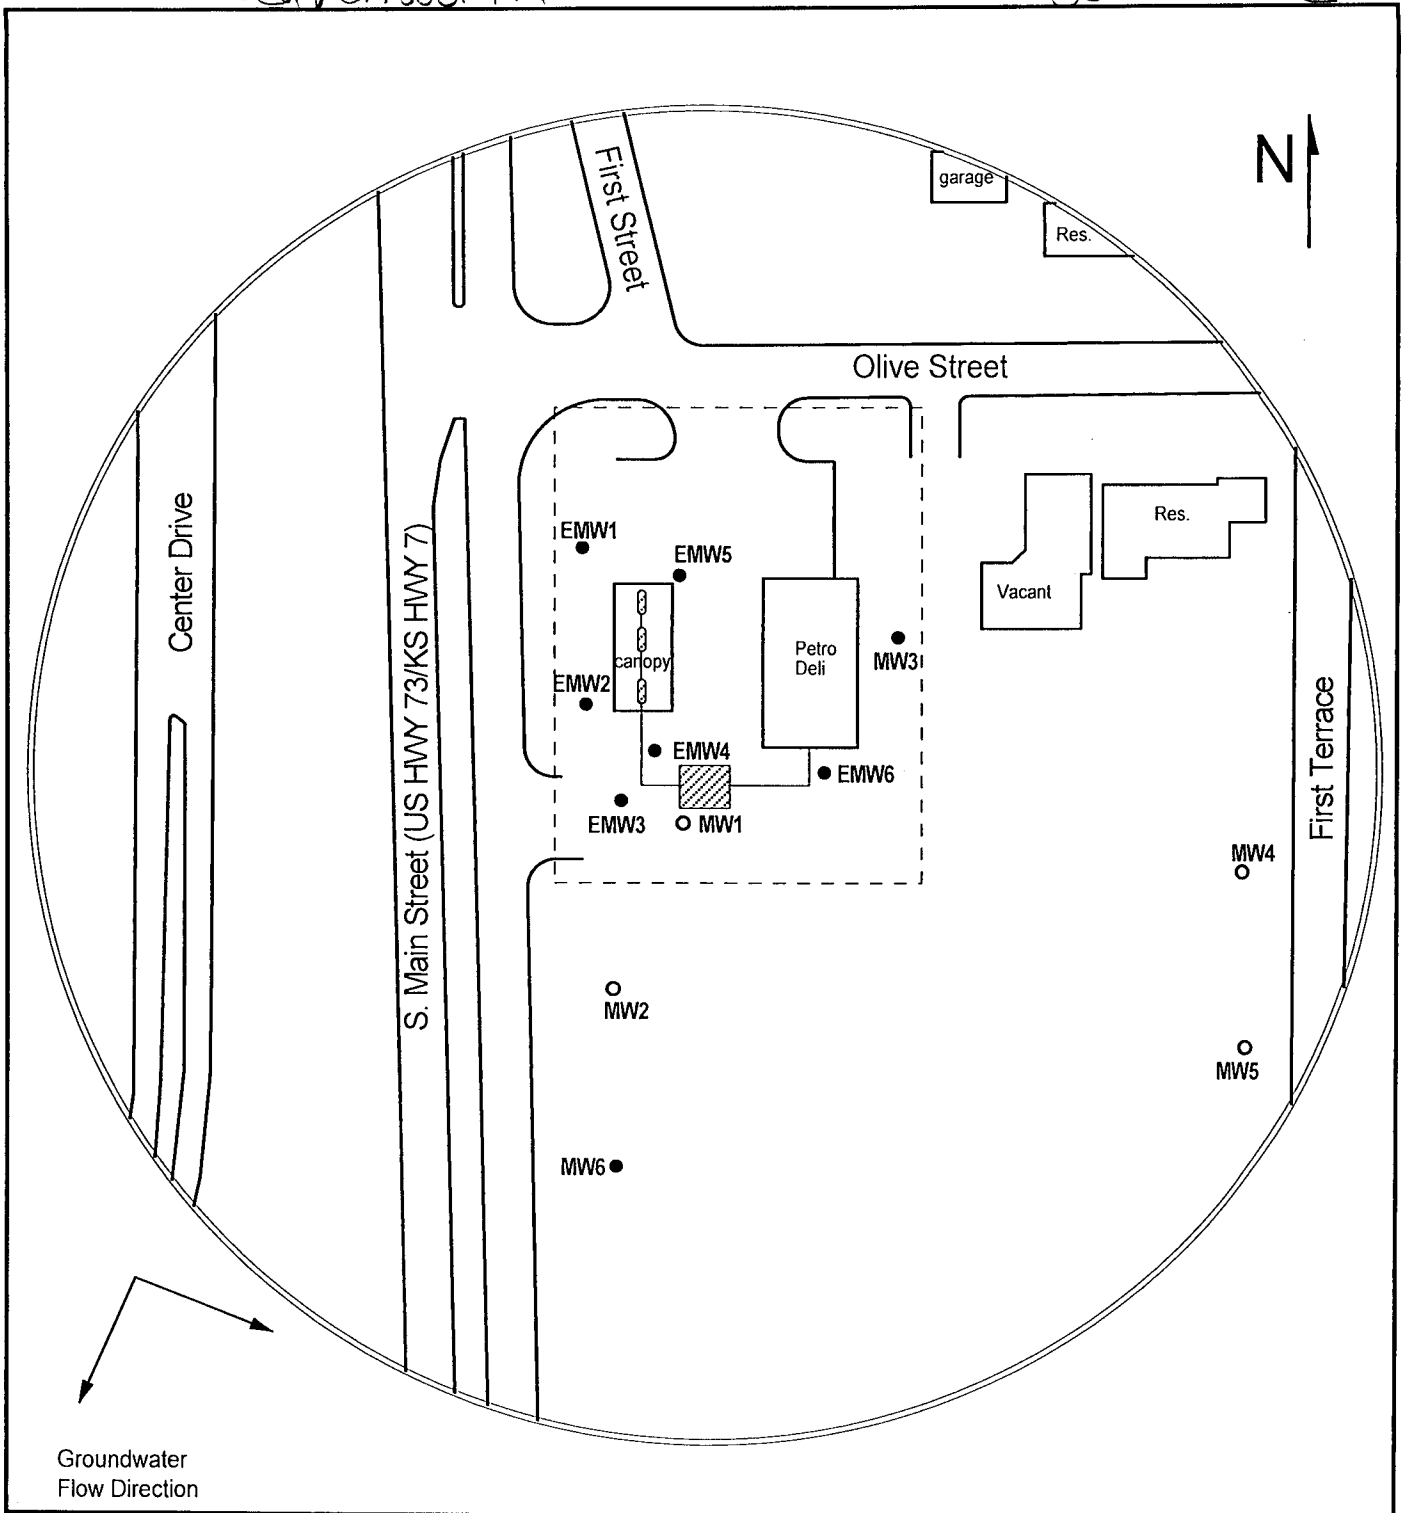


FIGURE 1 - SITE BASE MAP



PROJECT:

Seven Eleven #904
601 S. Main
Lansing, KS
KDHE ID: U4-052-10861
Date: 3/9/20

LEGEND:

- Approximate Location of Active UST Basin, Product Line and Pump Islands
- Approximate Location of Property Line
- Monitoring Well
- Plugged Monitoring Well

1311 E 25th St., Suite B (785) 841-8707 office
Lawrence, KS 66046 (785) 865-4282 fax

0 100 ft

A horizontal scale bar with markings at 0 and 100 feet.