


1 LOCATION OF WATER WELL: Fraction NW 1/4 SW 1/4 SW 1/4 Section Number 15 Township Number T 9 S Range Number R 3 E W
 County: Clay

Distance and direction from nearest town or city street address of well if located within city? South on 2nd Hwy & then Co 2 1/2 West on 10th Rd. From Clifton Co 17 miles

2 WATER WELL OWNER:
 RR#, St. Address, Box # :
 City, State, ZIP Code :
 Board of Agriculture, Division of Water Resources
 Application Number:

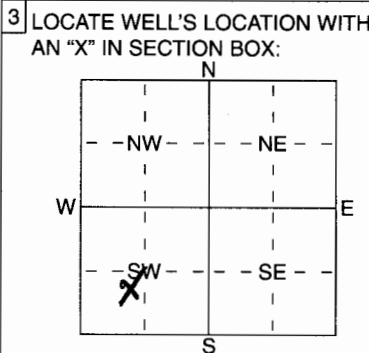

4 DEPTH OF COMPLETED WELL 148 ft. ELEVATION: ft.
 Depth(s) Groundwater Encountered 1 ft. 2 ft. 3 ft.
 WELL'S STATIC WATER LEVEL 90.84 ft. below land surface measured on mo/day/yr
 Pump test data: Well water was ft. after hours pumping gpm
 Est. Yield 30 gpm: Well water was ft. after hours pumping gpm
 WELL WATER TO BE USED AS:
 Domestic Feedlot Irrigation Industrial Public water supply Oil field water supply Domestic (lawn & garden) Air conditioning Dewatering Injection well Monitoring well Other (Specify below)
 Was a chemical/bacteriological sample submitted to Department? Yes No If yes, mo/day/yr sample was submitted
 Water Well Disinfected? Yes No

5 TYPE OF BLANK CASING USED:
 Steel RMP (SR) Wrought iron Concrete tile CASING JOINTS Glued Clamped
 PVC ABS Asbestos-Cement Other (specify below) welded
 Fiberglass Threaded
 Blank casing diameter 5 in. to 128 ft. Dia in. to ft. Dia in. to ft. Dia
 Casing height above land surface 2' in., weight 56.40 lbs./ft. Wall thickness or gauge No.
 TYPE OF SCREEN OR PERFORATION MATERIAL:
 Steel Stainless Steel Fiberglass RMP (SR) Asbestos-Cement
 Brass Galvanized Steel Concrete tile ABS Other (Specify)
 None used (open hole)
 SCREEN OR PERFORATION OPENINGS ARE:
 Continuous slot Mill slot Guazed wrapped Saw cut None (open hole)
 Louvered shutter Key punched Wire wrapped Drilled holes
 Torch cut Other (specify) ft.
 SCREEN-PERFORATED INTERVALS: From 128 ft. to 148 ft., From ft. to ft.
 GRAVEL PACK INTERVALS: From 25 ft. to 148 ft., From ft. to ft.

6 GROUT MATERIAL: Neat cement Cement grout Bentonite Other
 Grout Intervals: From 5 ft. to 25 ft., From ft. to ft., From ft. to ft.
 What is the nearest source of possible contamination:
 Septic tank Lateral lines Pit privy Livestock pens Abandoned water well
 Sewer lines Cess pool Sewage lagoon Fuel storage Oil well/Gas well
 Watertight sewer lines Seepage pit Feedyard Fertilizer storage Other (specify below)
 Insecticide storage
 Direction from well? How many feet?

FROM	TO	LITHOLOGIC LOG	FROM	TO	PLUGGING INTERVALS
0	1	Top Soil			
1	45	Brown Clay			
45	63	Limestone			
63	84	Gray Shell			
84	105	Limestone			
105	108	Tan Shell			
108	148	Limestone			

7 CONTRACTOR'S OR LANDOWNER'S CERTIFICATION: This water well was constructed, reconstructed, or plugged under my jurisdiction and was completed on (mo/day/year) 3/9/2006 and this record is true to the best of my knowledge and belief. Kansas Water Well Contractor's Licence No 451 This Water Well Record was completed on (mo/day/yr) 3/30/2006 under the business name of Holtzman Well Drilling by (signature) Craig W. Holtzman

INSTRUCTIONS: Use typewriter or ball point pen. PLEASE PRESS FIRMLY and PRINT clearly. Please fill in blanks, underline or circle the correct answers. Send top three copies to Kansas Department of Health and Environment, Bureau of Water, Geology Section, 1000 SW Jackson St., Suite 420, Topeka, Kansas 66612-1367. Telephone 785-296-5522. Send one to WATER WELL OWNER and retain one for your records. Fee of \$5.00 for each constructed well.