


1	LOCATION OF WATER WELL: County: <u>Clay</u>	Fraction <u>SE 1/4 SE 1/4 SE 1/4</u>	Section Number <u>20</u>	Township Number <u>9</u>	Range Number <u>3E</u>
---	--	---	-----------------------------	-----------------------------	---------------------------

Distance and direction from nearest town or city street address of well if located within city?
from Clay Center 9 miles south to 9th Rd, 1 mile east, 1/8 north west side

2	WATER WELL OWNER: <u>Mary Alexander</u> RR #, St. Address, Box #: <u>1752 16 Rd</u> City, State, ZIP Code: <u>Clay Center Ks 67432</u>	Board of Agriculture, Division of Water Resources Application Number:
---	--	--

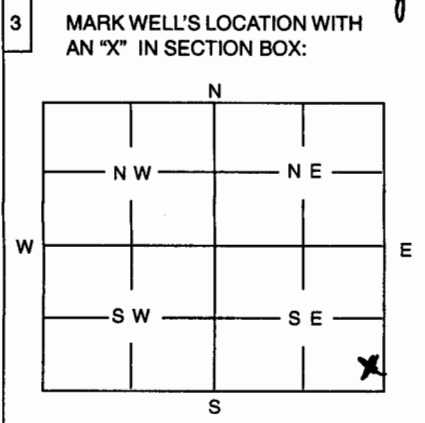

4	DEPTH OF WELL <u>170</u> ft WELL'S STATIC WATER LEVEL <u>20</u> ft	
WELL WAS USED AS:		
<input checked="" type="checkbox"/> Domestic	5 Public Water Supply	9 Dewatering
2 Irrigation	6 Oil Field Water Supply	10 Monitoring Well
3 Feedlot	7 Domestic (Lawn & Garden)	11 Injection Well
4 Industrial	8 Air Conditioning	12 Other
Was a chemical / bacteriological sample submitted to Department? Yes No <input checked="" type="checkbox"/> If yes, mo/day/yr sample was submitted		
Water Well Disinfected: Yes <input checked="" type="checkbox"/> No		

5	TYPE OF BLANK CASING USED:			
<input checked="" type="checkbox"/> Steel	3 RMP (SR)	5 Wrought	7 Fiberglass	9 Other (Specify below)
2 PVC	4 ABS	6 Asbestos-Cement	8 Concrete Tile	
Blank casing diameter <u>5</u> in. Was casing poled? Yes No <input checked="" type="checkbox"/> If yes, how much				
Casing height above or below land surface <u>4' below</u>				

6	GROUT PLUG MATERIAL: 1 Neat cement 2 Cement grout <input checked="" type="checkbox"/> Bentonite 4 Other		
Grout Plug Intervals: From <u>4</u> ft. to <u>10</u> ft., From ft. to ft., From to ft.			
What is the nearest source of possible contamination:			
1 Septic tank	6 Seepage pit	11 Fuel storage	16 Other (specify below)
2 Sewer lines	7 Pit privy	12 Fertilizer storage	<u>1A Field</u>
3 Watertight sewer lines	8 Sewage lagoon	13 Insecticide storage	
4 Lateral lines	9 Feedyard	14 Abandoned water well	
5 Cess Pool	10 Livestock pens	15 Oil well/Gas well	
Direction from well?		How many feet?	

FROM	TO	PLUGGING MATERIALS
<u>0</u>	<u>4'</u>	<u>Topsoil</u>
<u>4</u>	<u>10'</u>	<u>Bentonite hole plug</u>
<u>10</u>	<u>150'</u>	<u>subsoil</u>
<u>150</u>	<u>170'</u>	<u>chlorinated sand</u>

7	CONTRACTOR'S OR LANDOWNER'S CERTIFICATION: This water well was plugged under my jurisdiction and was completed on (mo/day/year) <u>3/26/08</u> and this record is true to the best of my knowledge and belief. Kansas Water Well Contractor's License No. <u>648</u> This Water Well Record was completed on (mo/day/year) <u>3/26/08</u> under the business name of <u>Thunder Pump + Plumbing LLC</u> by (signature) <u>Judd O. Anderson</u>
---	--

INSTRUCTIONS: Use typewriter or ball point pen. Please press firmly and print clearly. Please fill in blanks, underline or circle the correct answers. Send top three copies to Kansas Department of Health and Environment, Bureau of Water, Topeka, Kansas 66620-0001. Telephone: 785/296-3565. Send one to Water Well Owner and retain one for your records.