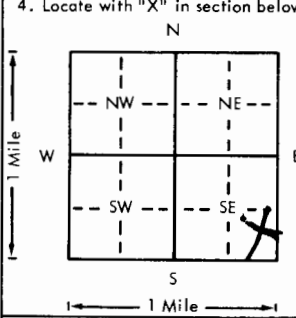


Before May 1 - 1980

USE TYPEWRITER OR BALL POINT PEN-PRESS FIRMLY, PRINT CLEARLY.

WATER WELL RECORD
KSA 82a-1201-1215

Kansas Department of Health and Environment-Division of Environment
(Water well Contractors)
Topeka, Kansas 66620

1. Location of well:	County Clay	Fraction NE 1/4 SE 1/4 SE 1/4	Section number 28	Township number 9 S R 3 E/W	Range number 3
2. Distance and direction from nearest town or city: 4 mi West on 82 H. & 1 1/4 mi north on West side of Road			3. Owner of well: Dallas Hess R.R. or street: RR 2 City, state, zip code: Wasefield Kans		
4. Locate with "X" in section below: 			6. Bore hole dia. 10 in. Completion date 4-15-80 Well depth 103 ft.		
5. Type and color of material			7. <input checked="" type="checkbox"/> Cable tool <input type="checkbox"/> Rotary <input type="checkbox"/> Driven <input type="checkbox"/> Dug <input type="checkbox"/> Hollow rod <input type="checkbox"/> Jetted <input type="checkbox"/> Bored <input type="checkbox"/> Reverse rotary		
			8. Use: <input checked="" type="checkbox"/> Domestic <input type="checkbox"/> Public supply <input type="checkbox"/> Industry <input type="checkbox"/> Irrigation <input type="checkbox"/> Air conditioning <input type="checkbox"/> Stock <input type="checkbox"/> Lawn <input type="checkbox"/> Oil field water <input type="checkbox"/> Other		
From To			9. Casing: Material PVC Height: Above or below Threaded <input type="checkbox"/> Welded <input type="checkbox"/> Surface 72 in. RMP <input type="checkbox"/> PVC <input checked="" type="checkbox"/> Weight 267 W.P. Dia. 5 in. to 103 ft. depth Wall Thickness: inches or Dia. <input type="checkbox"/> in. to <input type="checkbox"/> ft. depth gage No. <input type="checkbox"/>		
			10. Screen: Manufacturer's name Can-T-ef Type P.V.C. Dia. 5" Slot/gauge .040 Length 40' Set between 63 ft. and 103 ft. <input type="checkbox"/> ft. and <input type="checkbox"/> ft. Gravel pack? <input checked="" type="checkbox"/> Size range of material 1/8" X 1/4"		
to of Soil, Black Clay, yellow clay, Red Rock, Hard lime yellow Rock, Soft lime, Water at 80 ft 14-g.P.M. Shale, Red			11. Static water level: 73 ft. below land surface Date 4-15-80 mo./day/yr		
			12. Pumping level below land surfaces: <input type="checkbox"/> ft. after <input type="checkbox"/> hrs. pumping <input type="checkbox"/> g.p.m. <input type="checkbox"/> ft. after <input type="checkbox"/> hrs. pumping <input type="checkbox"/> g.p.m. Estimated maximum yield 14 g.p.m.		
			13. Water sample submitted: <input type="checkbox"/> Yes <input checked="" type="checkbox"/> No Date <input type="checkbox"/>		
			14. Well head completion: N.A. <input type="checkbox"/> Pitless adapter <input type="checkbox"/> Inches above grade		
			15. Well grouted? <input checked="" type="checkbox"/> 1-2' With: <input type="checkbox"/> Neat cement <input type="checkbox"/> Bentonite <input checked="" type="checkbox"/> Concrete Depth: From 19 ft. to 9 ft.		
			16. Nearest source of possible contamination: 600 ft. Direction South creek Well disinfected upon completion? <input checked="" type="checkbox"/> Yes <input type="checkbox"/> No		
			17. Pump: <input checked="" type="checkbox"/> Not installed Manufacturer's name <input type="checkbox"/> Model number <input type="checkbox"/> HP <input type="checkbox"/> Volts <input type="checkbox"/> Length of drop pipe <input type="checkbox"/> ft. capacity <input type="checkbox"/> g.p.m. Type: <input type="checkbox"/> Submersible <input type="checkbox"/> Turbine <input type="checkbox"/> Jet <input type="checkbox"/> Reciprocating <input type="checkbox"/> Centrifugal <input type="checkbox"/> Other		
18. Elevation:			19. Remarks:		
Topography: <input type="checkbox"/> Hill <input checked="" type="checkbox"/> Slope <input type="checkbox"/> Upland <input type="checkbox"/> Valley			20. Water well contractor's certification: This well was drilled under my jurisdiction and this report is true to the best of my knowledge and belief. Strader Drilling Co 237 Business name Blue Rapids K.S License No. <input type="checkbox"/> Address Harold Strader Date 4-15-80 Signed <input type="checkbox"/> Authorized representative		

T 9
R 3
W 28
Sec 28
NE SE SE