


1 LOCATION OF WATER WELL: County: CLAY Fraction: NW 1/4 NE 1/4 SE 1/4 Section Number: 34 Township Number: T 9 S Range Number: R 4 EW

Distance and direction from nearest town or city street address of well if located within city? From WAHLEFIELD GO 3 MILES WEST ON R-82 + 1/2 Mile North on Clay Co. on 859 + 2/10 THS EAST

2 WATER WELL OWNER: Fred Probst
 RR#, St. Address, Box #: Box 164
 City, State, ZIP Code: Garnett KS 67447
 Board of Agriculture, Division of Water Resources
 Application Number:

3 LOCATE WELL'S LOCATION WITH AN "X" IN SECTION BOX: 4 DEPTH OF COMPLETED WELL: 120 ft. ELEVATION: _____ ft.

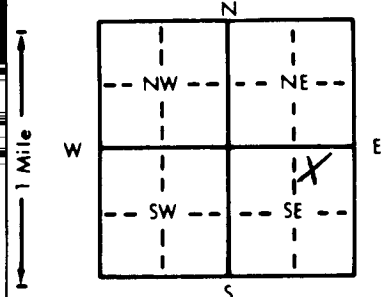

Depth(s) Groundwater Encountered 1. 9.3 ft. 2. _____ ft. 3. _____ ft.
 WELL'S STATIC WATER LEVEL 60 ft. below land surface measured on mo/day/yr _____
 Pump test data: Well water was _____ ft. after _____ hours pumping _____ gpm
 Est. Yield 200+ gpm: Well water was _____ ft. after _____ hours pumping _____ gpm
 Bore Hole Diameter 9 in. to 120 ft., and _____ in. to _____ ft.
 WELL WATER TO BE USED AS:
 1 Domestic 2 Irrigation 3 Feedlot 4 Industrial 5 Public water supply 6 Oil field water supply 7 Lawn and garden only 8 Air conditioning 9 Dewatering 10 Monitoring well 11 Injection well 12 Other (Specify below)
 Was a chemical/bacteriological sample submitted to Department? Yes _____ No _____ If yes, mo/day/yr sample was submitted _____
 Water Well Disinfected? Yes No

5 TYPE OF BLANK CASING USED:
 1 Steel 2 PVC 3 RMP (SR) 4 ABS 5 Wrought iron 6 Asbestos-Cement 7 Fiberglass 8 Concrete tile 9 Other (specify below)
 Blank casing diameter 5 in. to 100 ft., Dia _____ in. to _____ ft., Dia _____ in. to _____ ft.
 Casing height above land surface 2 in., weight Sub 40 lbs./ft. Wall thickness or gauge No. _____

TYPE OF SCREEN OR PERFORATION MATERIAL:
 1 Steel 2 Brass 3 Stainless steel 4 Galvanized steel 5 Fiberglass 6 Concrete tile 7 RMP (SR) 8 ABS 9 Other (specify) _____
 SCREEN OR PERFORATION OPENINGS ARE: 25/1000's
 1 Continuous slot 2 Mill slot 3 Key punched 4 Gauzed wrapped 5 Wire wrapped 6 Torch cut 7 Saw cut 8 Drilled holes 9 Other (specify) _____
 SCREEN-PERFORATED INTERVALS: From 1.00 ft. to 120 ft., From _____ ft. to _____ ft., From _____ ft. to _____ ft.
 GRAVEL PACK INTERVALS: From 2.5 ft. to 120 ft., From _____ ft. to _____ ft., From _____ ft. to _____ ft.

6 GROUT MATERIAL: 1 Neat cement 2 Cement grout 3 Bentonite 4 Other _____
 Grout Intervals: From 0 ft. to 2.5 ft., From _____ ft. to _____ ft., From _____ ft. to _____ ft.
 What is the nearest source of possible contamination: None Close
 1 Septic tank 2 Sewer lines 3 Watertight sewer lines 4 Lateral lines 5 Cess pool 6 Seepage pit 7 Pit privy 8 Sewage lagoon 9 Feedyard 10 Livestock pens 11 Fuel storage 12 Fertilizer storage 13 Insecticide storage 14 Abandoned water well 15 Oil well/Gas well 16 Other (specify below) _____
 Direction from well? _____ How many feet? _____

FROM	TO	LITHOLOGIC LOG	FROM	TO	PLUGGING INTERVALS
0	1	Top Soil			
1	21	Brown Clay			
21	23	Limestone			
23	25	Brown Shale			
35	37	Limestone			
37	49	Greenish Shale			
49	51	Limestone			
51	61	Yellow Shale			
61	63	Limestone			
63	93	Brown Shale			
93	114	Limestone (WATY)			
114	120	Yellow Shale			

7 CONTRACTOR'S OR LANDOWNER'S CERTIFICATION: This water well was (1) constructed, (2) reconstructed, or (3) plugged under my jurisdiction and was completed on (mo/day/year) 11/29/95 and this record is true to the best of my knowledge and belief. Kansas Water Well Contractor's License No. 451 This Water Well Record was completed on (mo/day/yr) 12/10/95 under the business name of Haldemor Well Drilling by (signature) Craig H. Caldwell