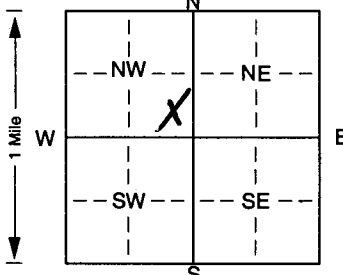


1] LOCATION OF WATER WELL: Fraction SE 1/4 SE 1/4 NW 1/4 Section Number 16 Township Number T 9 S Range Number R 4 E
 County: Clay
 Distance and direction from nearest town or city street address of well if located within city? From WALKFIELD GO 2 EAST ON 92 + 2 NORTH TO VALLEY VIEW RD. + 60 1/2 MILE ON 1079 RD.

2] WATER WELL OWNER: John Bond
 RR#, St. Address, Box #: 9146 S.E. PAULIN RD. Board of Agriculture, Division of Water Resources
 City, State, ZIP Code: BERRINGTON, KS 66409 Application Number:

3] LOCATE WELL'S LOCATION WITH AN "X" IN SECTION BOX:

 4] DEPTH OF COMPLETED WELL: 95 ft. ELEVATION:
 Depth(s) Groundwater Encountered: 1. 6.4 ft. 2. .ft. 3. .ft.
 WELL'S STATIC WATER LEVEL: 6.0 ft. below land surface measured on mo/day/yr
 Pump test data: Well water was .ft. after .hours pumping .gpm
 Est. Yield: 3 gpm Well water was .ft. after .hours pumping .gpm
 Bore Hole Diameter: .in. to 9.5 ft., and .in. to .ft.
 WELL WATER TO BE USED AS:
 1 Domestic 3 Feedlot 6 Oil field water supply 9 Dewatering 12 Other (Specify below)
 2 Irrigation 4 Industrial 7 Domestic (lawn & garden) 10 Monitoring well
 Was a chemical/bacteriological sample submitted to Department? Yes. . No. .; If yes, mo/day/yr sample was submitted
 Water Well Disinfected? Yes No

5] TYPE OF BLANK CASING USED:
 1 Steel 3 RMP (SR) 6 Asbestos-Cement 9 Other (specify below) Welded
 2 PVC 4 ABS 7 Fiberglass Threaded
 Blank casing diameter: 5 in. to 7.5 ft., Dia .in. to .ft., Dia .in. to .ft.
 Casing height above land surface: 2 in., weight SCH 40 lbs./ft. Wall thickness or gauge No. .
 TYPE OF SCREEN OR PERFORATION MATERIAL:
 1 Steel 3 Stainless steel 5 Fiberglass 7 PVC 10 Asbestos-cement
 2 Brass 4 Galvanized steel 6 Concrete tile 8 RMP (SR) 11 Other (specify) .
 12 None used (open hole)
 SCREEN OR PERFORATION OPENINGS ARE:
 1 Continuous slot 3 Mill slot 3/1000 5 Gauzed wrapped 8 Saw cut 11 None (open hole)
 2 Louvered shutter 4 Key punched 7 Torch cut 9 Drilled holes
 10 Other (specify) .ft.
 SCREEN-PERFORATED INTERVALS: From: 7.5 ft. to 9.5 ft., From .ft. to .ft.
 From: .ft. to .ft., From .ft. to .ft.
 GRAVEL PACK INTERVALS: From: 2.5 ft. to 9.5 ft., From .ft. to .ft.
 From: .ft. to .ft., From .ft. to .ft.

6] GROUT MATERIAL: 1 Neat cement 2 Cement grout 3 Bentonite 4 Other .
 Grout Intervals: From: 0 ft. to 2.5 ft., From .ft. to .ft., From .ft. to .ft.
 What is the nearest source of possible contamination:
 1 Septic tank 4 Lateral lines 7 Pit privy 10 Livestock pens 14 Abandoned water well
 2 Sewer lines 5 Cess pool 8 Sewage lagoon 11 Fuel storage 15 Oil well/Gas well
 3 Watertight sewer lines 6 Seepage pit None close 9 Feedyard 12 Fertilizer storage 16 Other (specify below)
 13 Insecticide storage .
 Direction from well? How many feet?

FROM	TO	LITHOLOGIC LOG	FROM	TO	PLUGGING INTERVALS
0	1	Top Soil			
1	7	Brown Clay			
7	28	Brown Shale			
28	57	Limestone			
57	64	Gray Shale			
64	68	Limestone			
68	74	Brown Shale			
74	79	Limestone			
79	80	Gray Shale			
80	95	Limestone			

7] CONTRACTOR'S OR LANDOWNER'S CERTIFICATION: This water well was (1) constructed, (2) reconstructed, or (3) plugged under my jurisdiction and was completed on (mo/day/year) 5/2/2002 and this record is true to the best of my knowledge and belief. Kansas Water Well Contractor's Licence No. 451 This Water Well Record was completed on (mo/day/yr) 5/3/2002 under the business name of Haldeman Well Drilling by (signature) Craig H. Cooper