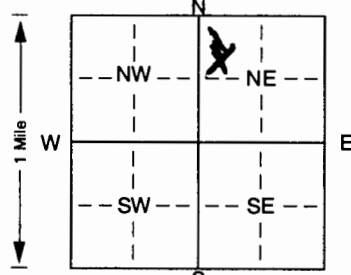


1 LOCATION OF WATER WELL: Fraction SW 1/4 NW 1/4 NE 1/4 Section Number 17 Township Number T 9 S Range Number R 4 E/W
 County: CLAY
 Distance and direction from nearest town or city street address of well if located within city? From Clay Center Mo 6 miles South East To Thunder Rd. then 60 2 1/2 South 1/2 East + 1/2 South

2 WATER WELL OWNER: PUT A. Pierson
 RR#, St. Address, Box #: 1084 Thunder Rd. Board of Agriculture, Division of Water Resources
 City, State, ZIP Code: Clay Center, Kansas 67432 Application Number:

3 LOCATE WELL'S LOCATION WITH AN "X" IN SECTION BOX:  DEPTH OF COMPLETED WELL: 160 ft. ELEVATION: ft.
 Depth(s) Groundwater Encountered: 1. 76 ft. 2. ft. 3. ft.
 WELL'S STATIC WATER LEVEL: 70 ft. below land surface measured on mo/day/yr ft.
 Pump test data: Well water was ft. after hours pumping gpm
 Est. Yield 1 gpm: Well water was ft. after hours pumping gpm
 Bore Hole Diameter: 9 in. to 160 ft., and in. to ft.
 WELL WATER TO BE USED AS: 5 Public water supply 8 Air conditioning 11 Injection well
1 Domestic 3 Feedlot 6 Oil field water supply 9 Dewatering 12 Other (Specify below)
2 Irrigation 4 Industrial 7 Domestic (lawn & garden) 10 Monitoring well
 Was a chemical/bacteriological sample submitted to Department? Yes. No. ; If yes, mo/day/yr sample was submitted
 Water Well Disinfected: Yes No

5 TYPE OF BLANK CASING USED: 5 Wrought iron 8 Concrete tile CASING JOINTS: Glued Clamped
1 Steel 3 RMP (SR) 6 Asbestos-Cement 9 Other (specify below) Welded
2 PVC 4 ABS 7 Fiberglass Threaded
 Blank casing diameter: 5 in. to 140 ft., Dia in. to ft., Dia in. to ft.
 Casing height above land surface: 2 in., weight 54.40 lbs./ft. Wall thickness or gauge No.
 TYPE OF SCREEN OR PERFORATION MATERIAL: 7 PVC 10 Asbestos-cement
 1 Steel 3 Stainless steel 5 Fiberglass 8 RMP (SR) 11 Other (specify)
 2 Brass 4 Galvanized steel 6 Concrete tile 9 ABS 12 None used (open hole)
 SCREEN OR PERFORATION OPENINGS ARE: 3 Mill slot 25/100 5 Gauzed wrapped 8 Saw cut 11 None (open hole)
 1 Continuous slot 4 Key punched 6 Wire wrapped 9 Drilled holes
 2 Louvered shutter 7 Torch cut 10 Other (specify) ft.
 SCREEN-PERFORATED INTERVALS: From: 1.42 ft. to 160 ft., From ft. to ft.
 From: ft. to ft., From ft. to ft.
 GRAVEL PACK INTERVALS: From: ft. to ft., From ft. to ft.
 From: ft. to ft., From ft. to ft.

6 GROUT MATERIAL: 1 Neat cement 2 Cement grout 3 Bentonite 4 Other
 Grout Intervals: From: 5 ft. to 25 ft., From ft. to ft., From ft. to ft.
 What is the nearest source of possible contamination:
 1 Septic tank 4 Lateral lines 7 Pit privy 10 Livestock pens 14 Abandoned water well
 2 Sewer lines 5 Cess pool 8 Sewage lagoon 11 Fuel storage 15 Oil well/Gas well
 3 Watertight sewer lines 6 Seepage pit 9 Feedyard 12 Fertilizer storage 16 Other (specify below)
 13 Insecticide storage
 Direction from well? How many feet?

FROM	TO	LITHOLOGIC LOG	FROM	TO	PLUGGING INTERVALS
0	1	Top Soil			
1	23	Brown Clay			
23	41	Sandy Clay			
41	50	Limestone			
50	59	Brown Shale			
59	63	Limestone			
63	76	Yellow Shale			
76	112	Limestone (water)			
112	118	Brown Shale			
118	132	Limestone			
132	139	Grey Shale			
139	154	Limestone			
154	160	Grey Shale			

7 CONTRACTOR'S OR LANDOWNER'S CERTIFICATION: This water well was (1) constructed, (2) reconstructed, or (3) plugged under my jurisdiction and was completed on (mo/day/year) 3/20/2002 and this record is true to the best of my knowledge and belief. Kansas Water Well Contractor's Licence No. 451 This Water Well Record was completed on (mo/day/yr) 3/25/2002 under the business name of Haldeman Well Drilling by (signature) Craig H. Haldeman

INSTRUCTIONS: Use typewriter or ball point pen. PLEASE PRESS FIRMLY and PRINT clearly. Please fill in blanks, underline or circle the correct answers. Send top three copies to Kansas Department of Health and Environment, Bureau of Water, Topeka, Kansas 66620-0001. Telephone 785-296-5524. Send one to WATER WELL OWNER and retain one for your records. Fee of \$5.00 for each constructed well.