

WATER WELL RECORD Form WWC-5


Original Record Correction Change in Well Use

Division of Water Resources App. No.

Well ID

1 LOCATION OF WATER WELL: County: Chay Fraction: SE 1/4 SW 1/4 NW 1/4 Section Number: 27 Township Number: T 9 S Range Number: R 4 E W

2 WELL OWNER: Last Name: Jackson First: Jamie Street or Rural Address where well is located (if unknown, distance and direction from nearest town or intersection): From Wakarusa Co East 3 miles on 87 Hwy thru Co 1 1/2 North property on East
 Business: 1325 Parrale Rd.
 Address: Chilton State: Ks ZIP: 66937

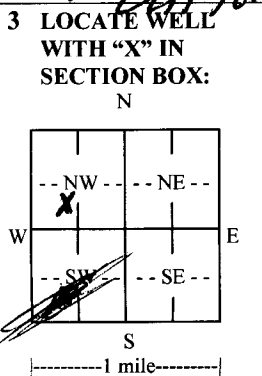

4 DEPTH OF COMPLETED WELL: 140' ft.
 Depth(s) Groundwater Encountered: 1) ft.
 2) ft. 3) ft., or 4) Dry Well
 WELL'S STATIC WATER LEVEL: 118' ft.
 below land surface, measured on (mo-day-yr)
 above land surface, measured on (mo-day-yr)
 Pump test data: Well water was ft.
 after hours pumping gpm
 Well water was ft.
 after hours pumping gpm
 Estimated Yield: 34 gpm
 Bore Hole Diameter: 9" in. to 140' ft. and
 in. to ft.

5 Latitude: (decimal degrees)
Longitude: (decimal degrees)
 Datum: WGS 84 NAD 83 NAD 27
Source for Latitude/Longitude:
 GPS (unit make/model:)
 (WAAS enabled? Yes No)
 Land Survey Topographic Map
 Online Mapper:

6 Elevation: ft. Ground Level TOC
 Source: Land Survey GPS Topographic Map
 Other

7 WELL WATER TO BE USED AS:

1. Domestic: Household Lawn & Garden Livestock
 Irrigation
 Feedlot
 Industrial

2. Public Water Supply: well ID
 Dewatering: how many wells?
 Aquifer Recharge: well ID
 Monitoring: well ID
 Environmental Remediation: well ID
 Air Sparge Soil Vapor Extraction
 Recovery Injection

10. Oil Field Water Supply: lease
 11. Test Hole: well ID
 Cased Uncased Geotechnical
 12. Geothermal: how many bores?
 a) Closed Loop Horizontal Vertical
 b) Open Loop Surface Discharge Inj. of Water
 13. Other (specify):

Was a chemical/bacteriological sample submitted to KDHE? Yes No If yes, date sample was submitted:

Water well disinfected? Yes No

8 TYPE OF CASING USED: Steel PVC Other CASING JOINTS: Glued Clamped Welded Threaded
 Casing diameter 5" in. to 120' ft., Diameter in. to ft., Diameter in. to ft.
 Casing height above land surface 2' in. Weight 5ch 40 lbs./ft. Wall thickness or gauge No.

TYPE OF SCREEN OR PERFORATION MATERIAL:
 Steel Stainless Steel Fiberglass PVC Other (Specify)
 Brass Galvanized Steel Concrete tile None used (open hole)

SCREEN OR PERFORATION OPENINGS ARE:
 Continuous Slot Mill Slot Gauze Wrapped Torch Cut Drilled Holes Other (Specify)
 Louvered Shutter Key Punched Wire Wrapped Saw Cut None (Open Hole)

SCREEN-PERFORATED INTERVALS: From 120' ft. to 140' ft., From ft. to ft., From ft. to ft.
 GRAVEL PACK INTERVALS: From 2.5' ft. to 140' ft., From ft. to ft., From ft. to ft.

9 GROUT MATERIAL: Neat cement Cement grout Bentonite Other
 Grout Intervals: From 5 ft. to 25 ft., From ft. to ft., From ft. to ft.

Nearest source of possible contamination: None Close

Septic Tank Lateral Lines Pit Privy Livestock Pens Insecticide Storage
 Sewer Lines Cess Pool Sewage Lagoon Fuel Storage Abandoned Water Well
 Watertight Sewer Lines Seepage Pit Feedyard Fertilizer Storage Oil Well/Gas Well
 Other (Specify)

Direction from well? Distance from well? ft.

10 FROM	TO	LITHOLOGIC LOG	FROM	TO	LITHO. LOG (cont.) or PLUGGING INTERVALS
0	1	Top Soil	54	67	Limestone
1	3	Greenish shale	67	88	Brown shale
3	3	Limestone	88	118	Grey Dry shale (water)
3	10	Yellow shale	118	126	Limestone
10	16	Limestone	126	130	Brown shale
16	31	Tan shale	130	140	Limestone
31	39	Dark Grey shale			
39	51	Limestone			
51	54	Tan shale			

11 CONTRACTOR'S OR LANDOWNER'S CERTIFICATION: This water well was constructed, reconstructed, or plugged under my jurisdiction and was completed on (mo-day-yr) 11/12/2014 and this record is true to the best of my knowledge and belief. Kansas Water Well Contractor's License No. 451 This Water Well Record was completed on (mo-day-yr) 12/2/2014 under the business name of Haldeman Well Drilling Leary M. CWD/DFP