


1 LOCATION OF WATER WELL: Fraction SW 1/4 SW 1/4 NW 1/4 Section Number 5 Township Number T 9 S Range Number R 4 E

Distance and direction from nearest town or city street address of well if located within city?  
 5 East, 5 1/2 South of Clay Center,

2 WATER WELL OWNER: Curtis Osbourn ~~Box~~ Estate, c/o Beverly Carlson  
 RR#, St. Address, Box #: Route 3, Box 28 Clay Center, Kansas 67432 Board of Agriculture, Division of Water Resources  
 City, State, ZIP Code: Application Number:

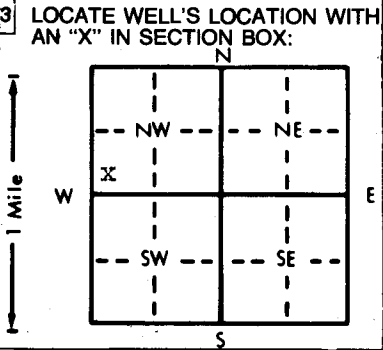

4 DEPTH OF COMPLETED WELL: 200 ft. ELEVATION:  
 Depth(s) Groundwater Encountered 1 ft. 2 ft. 3 ft.  
 WELL'S STATIC WATER LEVEL: 125 ft. below land surface measured on mo/day/yr 8/20/1983  
 Pump test data: Well water was NA ft. after hours pumping gpm  
 Est. Yield: 20 gpm; Well water was ft. after hours pumping gpm  
 Bore Hole Diameter: 9 in. to 200 ft., and in. to ft.  
 WELL WATER TO BE USED AS:  
 Domestic 3 Feedlot 6 Oil field water supply 9 Dewatering 12 Other (Specify below)  
 2 Irrigation 4 Industrial 7 Lawn and garden only 10 Observation well  
 Was a chemical/bacteriological sample submitted to Department? Yes No  X; If yes, mo/day/yr sample was submitted  
 Water Well Disinfected? Yes  X No

5 TYPE OF BLANK CASING USED:  
 1 Steel 3 RMP (SR) 5 Wrought iron 8 Concrete tile CASING JOINTS: Glued  X Clamped  
 PVC 4 ABS 6 Asbestos-Cement 9 Other (specify below) Welded  
 7 Fiberglass Threaded  
 Blank casing diameter: 5 in. to 140 ft., Dia 5 in. to 180 ft., Dia  
 Casing height above land surface: 12 in., weight 3 lbs./ft. Wall thickness or gauge No. 258  
 TYPE OF SCREEN OR PERFORATION MATERIAL:  
 PVC 10 Asbestos-cement  
 1 Steel 3 Stainless steel 5 Fiberglass 8 RMP (SR) 11 Other (specify)  
 2 Brass 4 Galvanized steel 6 Concrete tile 9 ABS 12 None used (open hole)  
 SCREEN OR PERFORATION OPENINGS ARE:  
 5 Gauzed wrapped  Saw cut 11 None (open hole)  
 1 Continuous slot 3 Mill slot 6 Wire wrapped 9 Drilled holes  
 2 Louvered shutter 4 Key punched 7 Torch cut 10 Other (specify)  
 SCREEN-PERFORATED INTERVALS: From 140 ft. to 160 ft., From 180 ft. to 200 ft.  
 GRAVEL PACK INTERVALS: From 14 ft. to 200 ft., From ft. to ft.

6 GROUT MATERIAL:  Neat cement 2 Cement grout 3 Bentonite 4 Other  
 Grout Intervals: From 4 ft. to 14 ft., From ft. to ft., From ft. to ft.  
 What is the nearest source of possible contamination:  
 Septic tank 4 Lateral lines 7 Pit privy 10 Livestock pens 14 Abandoned water well  
 2 Sewer lines 5 Cess pool 8 Sewage lagoon 11 Fuel storage 15 Oil well/Gas well  
 3 Watertight sewer lines 6 Seepage pit 9 Feedyard 12 Fertilizer storage 16 Other (specify below)  
 13 Insecticide storage  
 Direction from well? Southwest How many feet? 150

FROM	TO	LITHOLOGIC LOG	FROM	TO	LITHOLOGIC LOG
0	3	topsoil			
3	7	0/ brown clay			
7	12	20 limestone			
12	23	0/ brown clay			
23	28	20 limestone			
28	48	0/ blue clay			
48	66	20 limestone			
66	74	brown clay			
74	114	0/ red clay			
114	120	20 limestone			
120	200	?????? (could not bring any samples up drilling w/ air, and foam was tried also)			
200		stop (hole stood open however)			

7 CONTRACTOR'S OR LANDOWNER'S CERTIFICATION: This water well was  constructed, (2) reconstructed, or (3) plugged under my jurisdiction and was completed on (mo/day/year) 8/19/1983 and this record is true to the best of my knowledge and belief. Kansas Water Well Contractor's License No. 359 359 This Water Well Record was completed on (mo/day/yr) under the business name of Daryl Cox & Sons Inc, by (signature) Daryl Cox

INSTRUCTIONS: Use typewriter or ball point pen, PLEASE PRESS FIRMLY and PRINT clearly. Please fill in blanks, underline or circle the correct answers. Send top three copies to Kansas Department of Health and Environment, Division of Environment, Environmental Geology Section, Topeka, KS 66620. Send one to WATER WELL OWNER and retain one for your records.

DB

OFFICE USE ONLY  
H  
SEC.  
SW 1/4  
SW 1/4  
NW 1/4