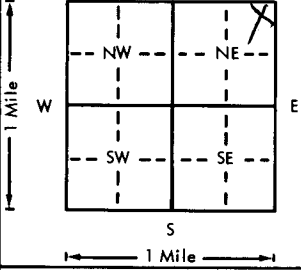


USE TYPEWRITER OR BALL POINT PEN—PRESS FIRMLY, PRINT CLEARLY.

WATER WELL RECORD
KSA 82a-1201-1215

Kansas Department of Health and Environment—Division of Environment
(Water well Contractors)
Topeka, Kansas 66620

1. Location of well:		County Clay	Fracture north east 1/4 1/4 1/4 1/4	Section number 6	Township number 9 South	Range number East R. East E/W	
2. Distance and direction from nearest town or city: 4 mi South Clay Center + 6 mi east Street address of well location if in city: South Side road			3. Owner of well: Alby Adamson R.R. or street: Clay Center Kans City, state, zip code:				
4. Locate with "X" in section below: N 				Sketch map:		6. Bore hole dia. 10 in. Completion date Well depth 130 ft. 2-17-77	
				7. <input checked="" type="checkbox"/> Cable tool <input type="checkbox"/> Rotary <input type="checkbox"/> Driven <input type="checkbox"/> Dug <input type="checkbox"/> Hollow rod <input type="checkbox"/> Jetted <input type="checkbox"/> Bored <input type="checkbox"/> Reverse rotary		8. Use: <input checked="" type="checkbox"/> Domestic <input type="checkbox"/> Public supply <input type="checkbox"/> Industry <input type="checkbox"/> Irrigation <input type="checkbox"/> Air conditioning <input type="checkbox"/> Stock <input type="checkbox"/> Lawn <input type="checkbox"/> Oil field water <input type="checkbox"/> Other	
5. Type and color of material				From	To	9. Casing: Material PVC Height: 0 or below Threaded <input type="checkbox"/> Welded <input type="checkbox"/> Surface 0 1/2 in. RMP <input type="checkbox"/> PVC <input type="checkbox"/> Weight _____ lbs./ft. Dia. 5 in. to 130 ft. depth Wall Thickness: inches or Dia. _____ in. to _____ ft. depth gage No. sch 40	
top Soil, Black				1	10	10. Screen: Manufacturer's name Pumped Type P.V.C. Dia. 5" Slot/gauze 0.40 Length 40 Set between 130 ft. and 90 ft. _____ ft. and _____ ft.	
Clay, yellow				10	60	Gravel pack? <input checked="" type="checkbox"/> Size range of material 1/8 X 1/4	
Rock, yellow lime				60	100	11. Static water level: _____ mo./day/yr. 80 ft. below land surface Date 2-17-77	
Shale, Blue				100	130	12. Pumping level below land surfaces: _____ ft. after _____ hrs. pumping _____ g.p.m. _____ ft. after _____ hrs. pumping _____ g.p.m. Estimated maximum yield 36 g.p.m.	
Shale, Red				130	130	13. Water sample submitted: _____ mo./day/yr. Yes <input checked="" type="checkbox"/> No <input type="checkbox"/> Date _____	
						14. Well head completion: NA _____ Pitless adapter _____ Inches above grade	
						15. Well grouted? <input checked="" type="checkbox"/> With: _____ Neat cement _____ Bentonite <input checked="" type="checkbox"/> Concrete Depth: From 10 ft. to 5 ft.	
						16. Nearest source of possible contamination: ft. 100' Direction west Type Waterway Well disinfected upon completion? <input checked="" type="checkbox"/> Yes <input type="checkbox"/> No	
						17. Pump: _____ Not installed Manufacturer's name _____ Model number _____ HP _____ Volts _____ Length of drop pipe _____ ft. capacity _____ g.p.m. Type: <input type="checkbox"/> Submersible <input type="checkbox"/> Turbine <input type="checkbox"/> Jet <input type="checkbox"/> Reciprocating <input type="checkbox"/> Centrifugal <input type="checkbox"/> Other	
				(Use a second sheet if needed)			
18. Elevation:		19. Remarks:		20. Water well contractor's certification: This well was drilled under my jurisdiction and this report is true to the best of my knowledge and belief. Strader Drilling Co. 537 Business name _____ License No. _____ Address Blue Rapids Signed Harold Strader Date 3-1-77 Authorized representative			

9-70-40-6-NE
 Sec 6-1/4-1/4-77

Forward the white, blue and pink copies to the Department of Health and Environment

Form WWC-5 -77