USE TYPEWRITER OR BALL POINT PEN-PRESS FIRMLY, PRINT CLEARLY.

T	R	EW	sec 1/4	1/4	1/4 No.
9	4	E	16	PE	NW

WATER WELL RECORD
KSA 82a-1201-1215

Kansas State Dept. Of Health
(Water Well Contractors)
Forbes-Bldg. 740
Topeka, Kansas 66620

NW SE NW

1 Location of well:	County	Township name	Fraction	Section number	Town number	Range number
	Clay	Grant	~~N.W.~~ 4	16	T 9 S	R 4 E

Distance and direction from nearest town or city: 10 miles S. E. - Clay Center

Street address of well location if in city:

3 Owner of well: Clay Center

Address: Gary Chaffee R-3

Locate with "X" in section below:

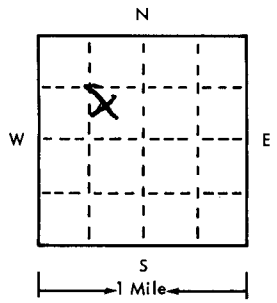

Sketch map:

4 Well depth: 101 ft. Date of completion July 29, 1975
Well diameter 7" in.

5 ☒ Cable tool ☐ Rotary ☐ Driven ☐ Dug
☐ Hollow rod ☐ Jetted ☐ Bored ☐ Reverse rotary

6 Use: ☒ Domestic ☐ Public supply ☐ Industry
☐ Irrigation ☐ Air conditioning ☐ Commercial
☐ Test well ☐

7 Casing: Material PLASTIC RMP Height: above/below
Threaded ☐ Welded ☐ Surface 12 in.
Diam. Weight ____ lbs./ft.
5" in. to 101 ft. depth Drive shoe? ☐ Yes ☒ No
5" in. to ____ ft. depth

8 Screen:
Manufacturer JESS-LOWELL
RMP Type PLASTIC Dia. 5"
Slot/gauze .060 Length 40
Set between 101 ft. and 61 ft.
Fittings:
Gravel pack ☒ Yes ☐ No Size range of material 1/4 X 1/4

9 Static water level:
70 ft. below land surface Date July 29, 1975

10 Pumping level below land surface: Bucketed
____ ft. after ____ hrs. pumping ____ g.p.m.
____ ft. after ____ hrs. pumping ____ g.p.m.
Estimated maximum yield 30 g.p.m.

11 Water sample submitted:
☐ Yes ☒ No Date ____

12 Well head completion: N/A
☐ Pitless adapter ☐ Inches above grade

13 Well grouted? ☒ Yes ☐ No
☒ Neat cement ☐ Bentonite ☐
Depth: From 6 ft. to 12 ft.

14 Nearest source of possible contamination:
ft. 100 Direction W W Type Hog's
Well disinfected upon completion? ☒ Yes ☐ No

15 Pump: ☒ Not installed
Manufacturer's name
Model number ____ HP ____ Volts ____
Length of drop pipe ____ ft. capacity ____ g.m.p.
Type:
☐ Submersible ☐ Turbine
☐ Jet ☐ Reciprocating
☐ Certrifugal ☐ Other

2 Type and color of material	From	To
BLACK TOP SOIL	1	3
yellow CLAY	3	15
JOINT CLAY yellow	15	22
SANDY CLAY	22	30
ROCK yellow	30	33
RED CLAY	33	60
yellow LIME ROCK	60	84
BLUE SHALE	84	101

(use a second sheet if needed)

16 Remarks: elevation

Topography:
☐ Hill
☒ Slope
☐ Upland
☐ Valley

17 Water well contractor's certification:
This well was drilled under my jurisdiction and this report is true to the best of my knowledge and belief.

Business name Blue Rapids License No. 137
Address Strader Drilling Co
Signed Harold Strader Date 7-29-75
Authorized representative

9 4E 16 NW SE NW

Forward the white, blue and pink copies to the Kansas State Dept. Of Health.

Form WWC-5

677-H