


LOCATION OF WATER WELL: County: RILEY Fraction: SW 1/4 SW 1/4 NW 1/4 Section Number: 24 Township Number: T 9 S Range Number: R 4 EW

Distance and direction from nearest town or city street address of well if located within city?
0.5 E & 3.75 S of Bala, Kansas

WATER WELL OWNER: FORT RILEY, KANSAS 66442
 RR#, St. Address, Box # :
 City, State, ZIP Code :
 Board of Agriculture, Division of Water Resources
 Application Number:

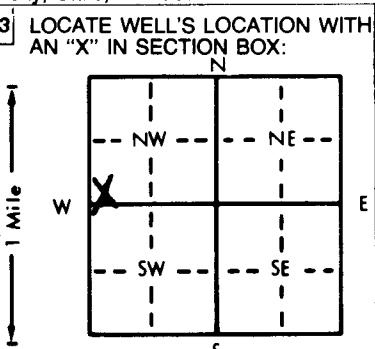

DEPTH OF COMPLETED WELL: 108 ft. ELEVATION:
 Depth(s) Groundwater Encountered 1. ft. 2. ft. 3. ft.
 WELL'S STATIC WATER LEVEL: 94 ft. below land surface measured on mo/day/yr 3/17/95
 Pump test data: Well water was ft. after hours pumping gpm
 Est. Yield gpm: Well water was ft. after hours pumping gpm
 Bore Hole Diameter in. to ft., and in. to ft.
 WELL WATER TO BE USED AS:
 1 Domestic 2 Irrigation 3 Feedlot 4 Industrial 5 Public water supply 6 Oil field water supply 7 Lawn and garden only 8 Air conditioning 9 Dewatering 10 Monitoring well 11 Injection well 12 Other (Specify below)
 Was a chemical/bacteriological sample submitted to Department? Yes.....No..... If yes, mo/day/yr sample was submitted
 Water Well Disinfected: Yes No

TYPE OF BLANK CASING USED:
 1 Steel 2 PVC 3 RMP (SR) 4 ABS 5 Wrought iron 6 Asbestos-Cement 7 Fiberglass 9 Other (specify below) Limestone Rock
 Blank casing diameter 36 in. to ft., Dia in. to ft., Dia in. to ft.
 Casing height above land surface 0 in., weight lbs./ft. Wall thickness or gauge No.
 TYPE OF SCREEN OR PERFORATION MATERIAL:
 12 None used (open hole)
 SCREEN OR PERFORATION OPENINGS ARE:
 11 None (open hole)
 SCREEN-PERFORATED INTERVALS: From NA ft. to NA ft., From ft. to ft.
 GRAVEL PACK INTERVALS: From ft. to ft., From ft. to ft.

GROUT MATERIAL: 3 Bentonite
 Grout Intervals: From 6 ft. to 3 ft., From ft. to ft., From ft. to ft.
 What is the nearest source of possible contamination:
 16 Other (specify below) None
 Direction from well? How many feet?

FROM	TO	LITHOLOGIC LOG	FROM	TO	PLUGGING INTERVALS
108	93	Sand & Gravel (105.9 cubic feet)			
93	6	Clay (614.6 cubic feet)			
6	3	Bentonite (21.2 cubic feet)			
3	0	Clay (21.2 cubic feet)			

RECEIVED
 MAR 28 1995
 SALINA OFFICE
 KDHE

CONTRACTOR'S OR LANDOWNER'S CERTIFICATION: This water well was (1) constructed, (2) reconstructed, or (3) plugged under my jurisdiction and was completed on (mo/day/year) 3-17-95 and this record is true to the best of my knowledge and belief. Kansas Water Well Contractor's License No. This Water Well Record was completed on (mo/day/yr) 3-22-95 under the business name of by (signature) Jaworski J Sample