


1 LOCATION OF WATER WELL: County: Riley Fraction: SW 1/4 SW 1/4 SE 1/4 Section Number: 5 Township Number: T 9 S Range Number: R 5 E/W

Distance and direction from nearest town or city street address of well if located within city?
from main street 1/4 East + 1/4 South

2 WATER WELL OWNER: Leland Heiks Riley County Permit
 RR#, St. Address, Box #: 313 North Main Board of Agriculture, Division of Water Resources
 City, State, ZIP Code: Riley, KS 66531 Application Number:

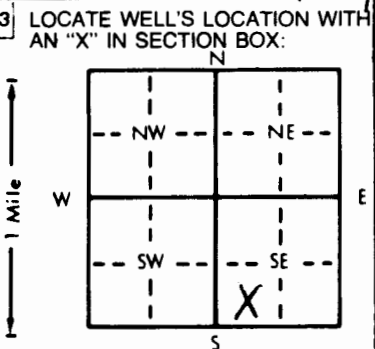

4 DEPTH OF COMPLETED WELL: 100' ft. ELEVATION: ft.
 Depth(s) Groundwater Encountered 1. 6.5 ft. 2. ft. 3. ft.
 WELL'S STATIC WATER LEVEL: 6.0 ft. below land surface measured on mo/day/yr
 Pump test data: Well water was ft. after hours pumping gpm
 Est. Yield: 3.00 gpm; Well water was ft. after hours pumping gpm
 Bore Hole Diameter: 9 in. to 100 in. to in. to in.
 WELL WATER TO BE USED AS:
 1 Domestic (circled) 3 Feedlot 6 Oil field water supply 9 Dewatering 12 Other (Specify below)
 2 Irrigation 4 Industrial 7 Lawn and garden only 10 Monitoring well
 Was a chemical/bacteriological sample submitted to Department? Yes..... No.....; If yes, mo/day/yr sample was submitted

5 TYPE OF BLANK CASING USED:
 1 Steel (circled) 3 RMP (SR) 5 Wrought iron 8 Concrete tile CASING JOINTS: Glued (circled) Clamped
 2 PVC (circled) 4 ABS 6 Asbestos-Cement 9 Other (specify below) Welded
 7 Fiberglass Threaded
 Blank casing diameter: 5 in. to 80 ft., Dia. in. to ft., Dia. in. to ft.
 Casing height above land surface: 2' in., weight 50.40 lbs./ft. Wall thickness or gauge No.
 TYPE OF SCREEN OR PERFORATION MATERIAL: PVC (circled)
 1 Steel 3 Stainless steel 5 Fiberglass 8 RMP (SR) 10 Asbestos-cement
 2 Brass 4 Galvanized steel 6 Concrete tile 9 ABS 11 Other (specify)
 12 None used (open hole)
 SCREEN OR PERFORATION OPENINGS ARE: 25/1000's (circled)
 1 Continuous slot 3 Mill slot (circled) 5 Gauzed wrapped 8 Saw cut 11 None (open hole)
 2 Louvered shutter 4 Key punched 6 Wire wrapped 9 Drilled holes
 7 Torch cut 10 Other (specify)
 SCREEN-PERFORATED INTERVALS: From 80 ft. to 100 ft., From ft. to ft.
 From ft. to ft., From ft. to ft.
 GRAVEL PACK INTERVALS: From 40 ft. to 100 ft., From ft. to ft.
 From ft. to ft., From ft. to ft.

6 GROUT MATERIAL: 1 Neat cement 2 Cement grout 3 Bentonite (circled) 4 Other
 Grout intervals: From 5 ft. to 40 ft., From ft. to ft., From ft. to ft.
 What is the nearest source of possible contamination: None Close
 1 Septic tank 4 Lateral lines 7 Pit privy 10 Livestock pens 14 Abandoned water well
 2 Sewer lines 5 Cess pool 8 Sewage lagoon 11 Fuel storage 15 Oil well/Gas well
 3 Watertight sewer lines 6 Seepage pit 9 Feedyard 12 Fertilizer storage 16 Other (specify below)
 13 Insecticide storage
 Direction from well? How many feet?

FROM	TO	LITHOLOGIC LOG	FROM	TO	PLUGGING INTERVALS
0	1	Top soil			
1	4	Brown clay			
4	17	limestone			
17	41	yellow shale			
41	44	limestone			
44	65	brown shale			
65	94	limestone (water)			
94	100	gray shale			

7 CONTRACTOR'S OR LANDOWNER'S CERTIFICATION: This water well was (1) constructed, (2) reconstructed, or (3) plugged under my jurisdiction and was completed on (mo/day/year) 3/18/97 and this record is true to the best of my knowledge and belief. Kansas Water Well Contractor's License No. 451 This Water Well Record was completed on (mo/day/yr) 4/12/97 under the business name of Haldeman Well Drilling by (signature) Carly J. Winkler

OFFICE USE ONLY
T
R
EW
SEC.