


1	LOCATION OF WATER WELL: Riley	Fraction NW NE SW ¼ ¼ ¼	Section Number 1	Township Number 9S	Range Number 5E
County: Riley E/W					

Distance and direction from nearest town or city street address of well if located within city?

City of Riley 204 S. Remele

2 WATER WELL OWNER: KDHE UST Time and Materials
1000 SW Jackson #410
RR #, St. Address, Box #: Topeka, Ks 66612-1367 Board of Agriculture, Division of Water Resources
City, State, ZIP Code: Topeka, Ks 66612-1367 Application Number:

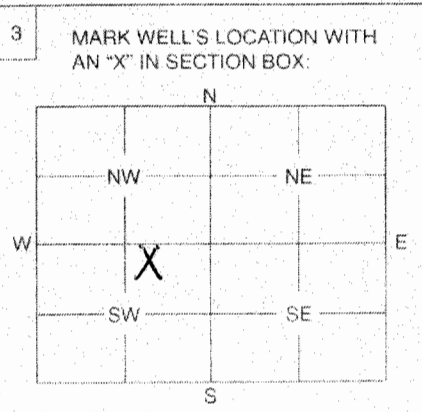

4 DEPTH OF WELL 8 ft.
WELL'S STATIC WATER LEVEL NA ft.
WELL WAS USED AS:
1 Domestic 5 Public Water Supply 9 Dewatering
2 Irrigation 6 Oil Field Water Supply 10 Monitoring Well
3 Feedlot 7 Domestic (Lawn & Garden) 11 Injection Well
4 Industrial 8 Air Conditioning 12 Other
Was a chemical / bacteriological sample submitted to Department? Yes No X
If yes, mo/day/yr sample was submitted
Water Well Disinfected: Yes No X

5 TYPE OF BLANK CASING USED:
1 Steel 3 RMP (SR) 5 Wrought 7 Fiberglass 9 Other (Specify below)
2 PVC 4 ABS 6 Asbestos-Cement 8 Concrete Tile
Blank casing diameter 2 in. Was casing pulled? Yes No X If yes, how much
Casing height above or below land surface in.

6 GROUT PLUG MATERIAL: 1 Neat cement 2 Cement grout 3 Bentonite 4 Other Concrete
Grout Plug Intervals: From 8 ft. to 1 ft. From 4 ft. to 1 ft. From 0 ft. to ft.
What is the nearest source of possible contamination:
1 Septic tank 6 Seepage pit 11 Fuel storage 12 Fertilizer storage 16 Other (specify below)
2 Sewer lines 7 Pit privy 13 Insecticide storage
3 Watertight sewer lines 8 Sewage lagoon 14 Abandoned water well
4 Lateral lines 9 Feedyard 15 Oil well/Gas well
5 Cess pool 10 Livestock pens
Direction from well? How many feet?

FROM	TO	PLUGGING MATERIALS
8	1	Bentonite
1	0	Concrete

7 CONTRACTOR'S OR LANDOWNER'S CERTIFICATION: This water well was plugged under my jurisdiction and was completed on (mo/day/year) 08/08/2008 and this record is true to the best of my knowledge and belief, Kansas Water Well Contractor's License No. 585 This Water Well Record was completed on (mo/day/year) 08/27/08 under the business name of Associated Environmental Engineering by (signature) *Ernie Johnson*

INSTRUCTIONS: Use typewriter or ball point pen. Please press firmly and print clearly. Please fill in blanks, underline or circle the correct answers. Send top three copies to Kansas Department of Health and Environment, Bureau of Water, Geology Section, 1000 SW Jackson St., Ste. 420, Topeka, Kansas 66612-1367. Telephone: 785/296-5522. Send one to Water Well Owner and retain one for your records.