


1 LOCATION OF WATER WELL: Fraction NE 1/4 NE 1/4 NE 1/4 Section Number 2 Township Number T 9 S Range Number R 5 EW  
 County: Riley  
 Distance and direction from nearest town or city street address of well if located within city? From Riley Co west 1/2 mile

2 WATER WELL OWNER: Scott E. Howe Riley Co. Application No. 94141  
 RR#, St. Address, Box #: 8050 Stockdale Rd. Board of Agriculture, Division of Water Resources  
 City, State, ZIP Code: Riley, KS 66531 Application Number:

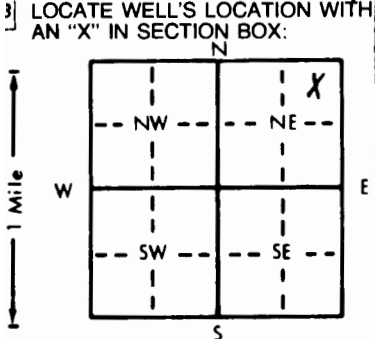

4 DEPTH OF COMPLETED WELL: 100 ft. ELEVATION: ..... ft.  
 Depth(s) Groundwater Encountered 1. 77 ft. 2. .... ft. 3. .... ft.  
 WELL'S STATIC WATER LEVEL: 40 ft. below land surface measured on mo/day/yr ..... ft.  
 Pump test data: Well water was ..... ft. after ..... hours pumping ..... gpm  
 Est. Yield 1.00 gpm: Well water was ..... ft. after ..... hours pumping ..... gpm  
 Bore Hole Diameter: 9 in. to 100 ft., and ..... in. to ..... ft.  
 WELL WATER TO BE USED AS:  
 1 Domestic     3 Feedlot     6 Oil field water supply     9 Dewatering     12 Other (Specify below)  
 2 Irrigation     4 Industrial     7 Lawn and garden only     10 Monitoring well  
 Was a chemical/bacteriological sample submitted to Department? Yes..... No.....; If yes, mo/day/yr sample was submitted  
 Water Well Disinfected?  Yes     No

5 TYPE OF BLANK CASING USED:  
 1 Steel     3 RMP (SR)     5 Wrought iron     8 Concrete tile    CASING JOINTS:  Glued     Clamped  
 2 PVC     4 ABS     6 Asbestos-Cement     9 Other (specify below)     Welded  
 Blank casing diameter: 5 in. to 80 ft., Dia. .... in. to .... ft., Dia. .... in. to .... ft.  
 Casing height above land surface: 2' in., weight 54006 lbs./ft. Wall thickness or gauge No. ....  
 TYPE OF SCREEN OR PERFORATION MATERIAL:  
 1 Steel     3 Stainless steel     5 Fiberglass     7 PVC     10 Asbestos-cement  
 2 Brass     4 Galvanized steel     6 Concrete tile     8 RMP (SR)     11 Other (specify) .....  
 3 Screen or perforation openings are: 25 1000's     5 Gauzed wrapped     8 Saw cut     11 None (open hole)  
 1 Continuous slot     3 Mill slot     6 Wire wrapped     9 Drilled holes  
 2 Louvered shutter     4 Key punched     7 Torch cut     10 Other (specify) .....  
 SCREEN-PERFORATED INTERVALS: From 80 ft. to 100 ft., From ..... ft. to ..... ft.  
 GRAVEL PACK INTERVALS: From 25 ft. to 100 ft., From ..... ft. to ..... ft.

6 GROUT MATERIAL:  1 Neat cement     2 Cement grout     3 Bentonite     4 Other  
 Grout Intervals: From 0 ft. to 25 ft., From ..... ft. to ..... ft., From ..... ft. to ..... ft.  
 What is the nearest source of possible contamination: None Close  
 1 Septic tank     4 Lateral lines     7 Pit privy     10 Livestock pens     14 Abandoned water well  
 2 Sewer lines     5 Cess pool     8 Sewage lagoon     11 Fuel storage     15 Oil well/Gas well  
 3 Watertight sewer lines     6 Seepage pit     9 Feedyard     12 Fertilizer storage     16 Other (specify below)  
 13 Insecticide storage  
 Direction from well? How many feet?

FROM	TO	LITHOLOGIC LOG	FROM	TO	PLUGGING INTERVALS
0	2	Top Soil			
2	8	Brown Clay			
8	9	Limestone			
9	24	Yellow shale			
24	48	Brown shale			
48	66	Limestone			
66	77	Brown shale			
77	88	Limestone (water)			
88	100	Tan shale			

7 CONTRACTOR'S OR LANDOWNER'S CERTIFICATION: This water well was  (1) constructed,  (2) reconstructed, or  (3) plugged under my jurisdiction and was completed on (mo/day/year) 6/27/94 and this record is true to the best of my knowledge and belief. Kansas Water Well Contractor's License No. 451 This Water Well Record was completed on (mo/day/yr) 7/24/94 under the business name of Haldeman Well Drilling by (signature) [Signature]

OFFICE USE ONLY  
T  
R  
EW  
SEC.  
1/4  
1/4  
1/4