


| | | | | |
|--|----------------------------------|---------------------|--------------------------|------------------------|
| 1 LOCATION OF WATER WELL: County: RILEY | Fraction NE 1/4 NE 1/4 SE 1/4 | Section Number 3 | Township Number T 9 S | Range Number R 5 EW |
|--|----------------------------------|---------------------|--------------------------|------------------------|

Distance and direction from nearest town or city street address of well if located within city?
1 mile west of Riley

2 WATER WELL OWNER: Kevin Stilley
 RR#, St. Address, Box #: 1809 Poyntz Board of Agriculture, Division of Water Resources
 City, State, ZIP Code: Manhattan, KS 66502 Application Number:

3 LOCATE WELL'S LOCATION WITH AN "X" IN SECTION BOX:

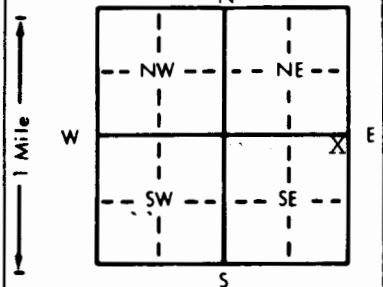

4 DEPTH OF COMPLETED WELL: 100 ft. ELEVATION:
 Depth(s) Groundwater Encountered 1. 85' ft. 2. ft. 3. ft.
 WELL'S STATIC WATER LEVEL 38' ft. below land surface measured on mo/day/yr 1-29-92
 Pump test data: Well water was ft. after hours pumping gpm
 Est. Yield .25 gpm: Well water was ft. after hours pumping gpm
 Bore Hole Diameter 8 3/4 in. to ft., and in. to ft.
 WELL WATER TO BE USED AS:
 5 Public water supply 8 Air conditioning 11 Injection well
 1 Domestic 3 Feedlot 6 Oil field water supply 9 Dewatering 12 Other (Specify below)
 2 Irrigation 4 Industrial 7 Lawn and garden only 10 Monitoring well
 Was a chemical/bacteriological sample submitted to Department? Yes No X; If yes, mo/day/yr sample was submitted
 Water Well Disinfected? Yes X No

5 TYPE OF BLANK CASING USED:
 1 Steel 3 RMP (SR) 5 Wrought iron 8 Concrete tile CASING JOINTS: Glued X Clamped
 2 PVC 4 ABS 6 Asbestos-Cement 9 Other (specify below) Welded
 7 Fiberglass Threaded
 Blank casing diameter 5" in. to 0-80 ft., Dia in. to ft., Dia in. to ft.
 Casing height above land surface 24" in., weight 2.82 lbs./ft. Wall thickness or gauge No. 258
 TYPE OF SCREEN OR PERFORATION MATERIAL:
 1 Steel 3 Stainless steel 5 Fiberglass 8 RMP (SR) 10 Asbestos-cement 11 Other (specify)
 2 Brass 4 Galvanized steel 6 Concrete tile 9 ABS 12 None used (open hole)
 SCREEN OR PERFORATION OPENINGS ARE:
 1 Continuous slot 3 Mill slot 5 Gauzed wrapped 8 Saw cut 11 None (open hole)
 2 Louvered shutter 4 Key punched 6 Wire wrapped 9 Drilled holes
 7 Torch cut 10 Other (specify)
 SCREEN-PERFORATED INTERVALS: From 80 ft. to 100 ft., From ft. to ft., From ft. to ft.
 GRAVEL PACK INTERVALS: From 24 ft. to 100 ft., From ft. to ft., From ft. to ft.

6 GROUT MATERIAL: 1 Neat cement 2 Cement grout 3 Bentonite 4 Other
 Grout intervals: From 4 ft. to 24 ft., From ft. to ft., From ft. to ft.
 What is the nearest source of possible contamination:
 1 Septic tank 4 Lateral lines 7 Pit privy 10 Livestock pens 14 Abandoned water well
 2 Sewer lines 5 Cess pool 8 Sewage lagoon 11 Fuel storage 15 Oil well/Gas well
 3 Watertight sewer lines 6 Seepage pit 9 Feedyard 12 Fertilizer storage 16 Other (specify below)
 13 Insecticide storage
 Direction from well? east How many feet? 325'

| FROM | TO | LITHOLOGIC LOG | FROM | TO | PLUGGING INTERVALS |
|------|-----|------------------------|------|----|--------------------|
| 0 | 1 | Top Soil | | | |
| 1 | 11 | Clay-Brown | | | |
| 11 | 12 | Limestone-Tan | | | |
| 12 | 27 | Shale-Yellow | | | |
| 27 | 30 | Limestone-Yellow | | | |
| 30 | 41 | Shale-Yellow | | | |
| 41 | 43 | Limestone-Yellow | | | |
| 43 | 49 | Shale-Yellow | | | |
| 49 | 52 | Limestone-Yellow | | | |
| 52 | 54 | Shale-Yellow | | | |
| 54 | 67 | Shale-Red | | | |
| 67 | 69 | Shale-Yellow | | | |
| 69 | 84 | Shale-Red | | | |
| 84 | 87 | Limestone-Yellow-loose | | | |
| 87 | 100 | Shale-Grey | | | |

7 CONTRACTOR'S OR LANDOWNER'S CERTIFICATION: This water well was (1) constructed, (2) reconstructed, or (3) plugged under my jurisdiction and was completed on (mo/day/year) 1-29-92 and this record is true to the best of my knowledge and belief. Kansas Water Well Contractor's License No. 182 This Water Well Record was completed on (mo/day/yr) 2-4-92 under the business name of STRADER DRILLING CO., INC. by (signature) Dale Uskren

OFFICE USE ONLY

T

R

EW

SEC.

1/4

1/4

1/4