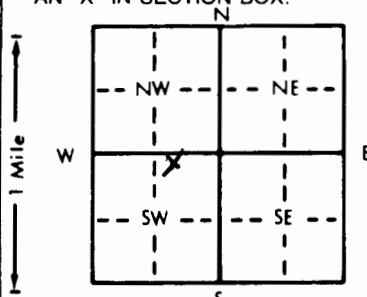


1 LOCATION OF WATER WELL: County: Riley Fraction: NW 1/4 NE 1/4 SW 1/4 Section Number: 1 Township Number: T 9 S Range Number: R 5 E/W

Distance and direction from nearest town or city street address of well if located within city?
36 South Broadway, Riley Kansas City Right of Way MW-16A

2 WATER WELL OWNER: KONE UST section
 RR#, St. Address, Box #: Bldg 740 Forbes Field Board of Agriculture, Division of Water Resources
 City, State, ZIP Code: Topeka KANSAS 66620 Application Number:

3 LOCATE WELL'S LOCATION WITH AN "X" IN SECTION BOX:  4 DEPTH OF COMPLETED WELL: 29 ft. ELEVATION: _____
 Depth(s) Groundwater Encountered: 1 26' ft. 2. _____ ft. 3. _____ ft.
 WELL'S STATIC WATER LEVEL: ab ft. below land surface measured on mo/day/yr _____
 Pump test data: Well water was _____ ft. after _____ hours pumping _____ gpm
 Est. Yield _____ gpm: Well water was _____ ft. after _____ hours pumping _____ gpm
 Bore Hole Diameter: 7 1/4 in. to 29 ft., and _____ in. to _____ ft.
 WELL WATER TO BE USED AS: 5 Public water supply 8 Air conditioning 11 Injection well
 1 Domestic 3 Feedlot 6 Oil field water supply 9 Dewatering 12 Other (Specify below)
 2 Irrigation 4 Industrial 7 Lawn and garden only 10 Monitoring well _____
 Was a chemical/bacteriological sample submitted to Department? Yes _____ No X; If yes, mo/day/yr sample was submitted _____
 Water Well Disinfected? Yes _____ No X

5 TYPE OF BLANK CASING USED: 1 Steel 2 PVC 3 RMP (SR) 4 ABS 5 Wrought iron 6 Asbestos-Cement 7 Fiberglass 8 Concrete tile 9 Other (specify below) CASING JOINTS: Glued _____ Clamped _____ Welded _____ Threaded X
 Blank casing diameter: 2 in. to 14 ft., Dia _____ in. to _____ ft., Dia _____ in. to _____ ft.
 Casing height above land surface: 0 in., weight _____ lbs./ft. Wall thickness or gauge No. sch 40
 TYPE OF SCREEN OR PERFORATION MATERIAL: 1 Steel 2 Brass 3 Stainless steel 4 Galvanized steel 5 Fiberglass 6 Concrete tile 7 PVC 8 RMP (SR) 9 ABS 10 Asbestos-cement 11 Other (specify) _____ 12 None used (open hole)
 SCREEN OR PERFORATION OPENINGS ARE: 1 Continuous slot 2 Louvered shutter 3 Mill slot 4 Key punched 5 Gauzed wrapped 6 Wire wrapped 7 Torch cut 8 Saw cut 9 Drilled holes 10 Other (specify) _____ 11 None (open hole)
 SCREEN-PERFORATED INTERVALS: From 29 ft. to 14 ft., From _____ ft. to _____ ft.
 GRAVEL PACK INTERVALS: From 29 ft. to 12 ft., From _____ ft. to _____ ft.

6 GROUT MATERIAL: 1 Neat cement 2 Cement grout 3 Bentonite 4 Other _____
 Grout Intervals: 3 From 12 ft. to 10 ft., 2 From 10 ft. to 0 ft., From _____ ft. to _____ ft.
 What is the nearest source of possible contamination: 1 Septic tank 2 Sewer lines 3 Watertight sewer lines 4 Lateral lines 5 Cess pool 6 Seepage pit 7 Pit privy 8 Sewage lagoon 9 Feedyard 10 Livestock pens 11 Fuel storage 12 Fertilizer storage 13 Insecticide storage 14 Abandoned water well 15 Oil well/Gas well 16 Other (specify below) UST
 Direction from well? South How many feet? 10

FROM	TO	LITHOLOGIC LOG	FROM	TO	PLUGGING INTERVALS
0	9.5	Silty Clay			
9.5	29	Interbedded Limestone/Shale			
		VARIANCE Requested Flush Mount Grout Interval			

7 CONTRACTOR'S OR LANDOWNER'S CERTIFICATION: This water well was (1) constructed, (2) reconstructed, or (3) plugged under my jurisdiction and was completed on (mo/day/year) 12-23-94 and this record is true to the best of my knowledge and belief. Kansas Water Well Contractor's License No. 575 This Water Well Record was completed on (mo/day/yr) 1-9-95 under the business name of Kurtz Environmental by (signature) _____

OFFICE USE ONLY
T
R
E/W
SEC.
1/4
1/4
1/4