


1 LOCATION OF WATER WELL: County: Riley Fraction: SW 1/4 SW 1/4 NW 1/4 Section Number: 1 Township Number: T 9 S Range Number: R 5 E

Distance and direction from nearest town or city street address of well if located within city?
110 N. Main, Riley, Kansas City Right of Way MW-4A

2 WATER WELL OWNER: KDHE - UST section
 RR#, St. Address, Box #: Box 740 Forbes Field Board of Agriculture, Division of Water Resources
 City, State, ZIP Code: Topeka Kansas 66620 Application Number:

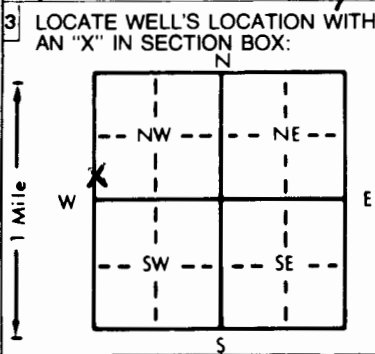

4 DEPTH OF COMPLETED WELL: 20 ft. ELEVATION: _____ ft.
 Depth(s) Groundwater Encountered: 1. 14' ft. 2. _____ ft. 3. _____ ft.
 WELL'S STATIC WATER LEVEL _____ ft. below land surface measured on mo/day/yr
 Pump test data: Well water was _____ ft. after _____ hours pumping _____ gpm
 Est. Yield _____ gpm: Well water was _____ ft. after _____ hours pumping _____ gpm
 Bore Hole Diameter: 7 1/4 in. to 20 ft., and _____ in. to _____ ft.
 WELL WATER TO BE USED AS:
 5 Public water supply 8 Air conditioning 11 Injection well
 1 Domestic 3 Feedlot 6 Oil field water supply 9 Dewatering 12 Other (Specify below)
 2 Irrigation 4 Industrial 7 Lawn and garden only 10 Monitoring well
 Was a chemical/bacteriological sample submitted to Department? Yes _____ No X If yes, mo/day/yr sample was submitted _____
 Water Well Disinfected? Yes _____ No X

5 TYPE OF BLANK CASING USED:
 1 Steel 3 RMP (SR) 5 Wrought iron 8 Concrete tile CASING JOINTS: Glued _____ Clamped _____
 2 PVC 4 ABS 6 Asbestos-Cement 9 Other (specify below) Welded _____
 Blank casing diameter _____ in. to 10 ft., Dia _____ in. to _____ ft., Dia _____ in. to _____ ft.
 Casing height above land surface: 0 in., weight _____ lbs./ft. Wall thickness or gauge No. Sch 40
 TYPE OF SCREEN OR PERFORATION MATERIAL:
 1 Steel 3 Stainless steel 5 Fiberglass 8 RMP (SR) 10 Asbestos-cement
 2 Brass 4 Galvanized steel 6 Concrete tile 9 ABS 11 Other (specify) _____
 12 None used (open hole)
 SCREEN OR PERFORATION OPENINGS ARE:
 1 Continuous slot 3 Mill slot 5 Gauzed wrapped 8 Saw cut 11 None (open hole)
 2 Louvered shutter 4 Key punched 6 Wire wrapped 9 Drilled holes
 7 Torch cut 10 Other (specify) _____
 SCREEN-PERFORATED INTERVALS: From 20 ft. to 10 ft., From _____ ft. to _____ ft.
 From _____ ft. to _____ ft., From _____ ft. to _____ ft.
 GRAVEL PACK INTERVALS: From 20 ft. to 9 ft., From _____ ft. to _____ ft.
 From _____ ft. to _____ ft., From _____ ft. to _____ ft.

6 GROUT MATERIAL: 1 Neat cement 2 Cement grout 3 Bentonite 4 Other
 Grout Intervals: 2 From 9 ft. to 7 ft., 3 From 7 ft. to 0 ft., From _____ ft. to _____ ft.
 What is the nearest source of possible contamination:
 1 Septic tank 4 Lateral lines 7 Pit privy 10 Livestock pens 14 Abandoned water well
 2 Sewer lines 5 Cess pool 8 Sewage lagoon 11 Fuel storage 15 Oil well/Gas well
 3 Watertight sewer lines 6 Seepage pit 9 Feedyard 12 Fertilizer storage 16 Other (specify below)
 Direction from well? South How many feet? 130'
UST

FROM	TO	LITHOLOGIC LOG	FROM	TO	PLUGGING INTERVALS
<u>0</u>	<u>11</u>	<u>CLAY</u>			
<u>11</u>	<u>20</u>	<u>Interbedded Limestone / Shale</u>			
		<u>VARIANCE Requested</u>			
		<u>Flush Mount</u>			
		<u>Grout Interval</u>			

7 CONTRACTOR'S OR LANDOWNER'S CERTIFICATION: This water well was (1) constructed, (2) reconstructed, or (3) plugged under my jurisdiction and was completed on (mo/day/year) 12-16-94 and this record is true to the best of my knowledge and belief. Kansas Water Well Contractor's License No. 575 This Water Well Record was completed on (mo/day/yr) 1-28-95 under the business name of Kurtz Environmental by (signature) _____

OFFICE USE ONLY
T
R
EM
SEC.